

GOVERNMENT CORNER RESTORATION FORM

FILED

TOWNSHIP 26S RANGE 3W SEC. 1

PLSS # 602605

Date: 4/8/20 By: ke  
This survey consists of:

DOUGLAS COUNTY OREGON

DATE 4-1-26

Map: \_\_\_\_\_

Narrative: \_\_\_\_\_  
Corner Rpt: CS 67162-37

Corner Designation

CC COR S2|S1

DOUGLAS COUNTY  
SURVEYOR

Monument(s) Found: (Condition and Source)

2 1/2" DCSO BRASS CAP  
proj 9"

\_\_\_ Condition report

\_\_\_ Not Found

Renewed

\_\_\_ Unrecorded

\_\_\_ Surveyed In

Previous Renewals

GLD Survey 1896 Vol 11 pg 4460-1

DCSO 1968 CS 54/72-3

BLM Recovery 1971 Vol 37 pg 15216

BLM Recovery 1983 Vol 43 pg 16755-6

MONUMENT DETAIL

COUNTY SURVEYORS  
OFFICE

T26S R8W

S2|S1

Accessories Found

Very Rotted 52" x 2FT D. FIR STUMP S85°W  
18.5 FT

Shattered Rotted 12" x 2FT Hemlock SWAG  
N57°E 25.1 FT Fragmentary Scribes  
Visible

17" Hemlock N87°W 25.2 FT (REC 41 LKS)

Blaze Not Visible

A Steel Post 0.6 FT North

New Accessories

Three Unrecorded B.T.s one unknown  
 Origin 2 are 2023 Weyerhaeuser  
 19" Hemlock Painted up as BT No Blaze  
 Evidence N58°E 33.4 FT  
 6" D. Fir N83°E 32.9 FT (Tag says S83°W  
 23.1 Dist Transposed?) Scribed 511 BT on  
 Single Blaze  
 A 7" D. Fir S51°W 22.0 FT (Tag N51°E 21.5)  
 Scribed 14 51 BT on Single Blaze

Sketch of Monument, Accessories, and General Area

Location & Comments

MON on moderate North  
 Slope in older Reprod


MON IS APPROX  
 55 FT NORTH OF  
 DIRT ROAD

Trimble GEO XT Position

N 43.33091042° W 123.6039917°

Comp. Decline. 1414°E  
 Agency DCSD  
 Party Chief S. F. ROUSE  
 Note keeper  
 Witnesses J. LORSUM

CS 67162-37 pg 2/3

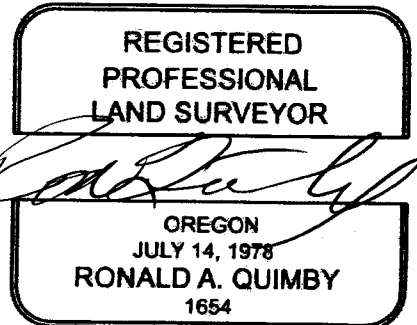

EXPIRES: 12/31/2026

TOWNSHIP 26 RANGE 08 POINT IDENTIFIER # 602600

PRIMARY CORNER DESCRIPTION Closing Corner Secs 1 & 2 (South)

Alias _____	Description _____
Alias _____	Description <u>TRIMBLE GEO XT POSITION</u>
Alias _____	Description _____
Alias _____	Description <u>43.33091042</u>

123.60399917

New BTs- 8" Hemlock N.43°W. 24.8 ft. Mkd. T26S R8W S2 CS BT.  
9" Hemlock N.57°E. 25.0 ft. Mkd. T26S R8W S1 CS BT.  
This corner lies on moderate northerly- slope, 150 ft E of CC

Fd. & used on Dependent resurvey by Peter A. Peterson & Daniel L. Berry, Cadastral Surveyors, under Group No. 739, surveyed May/July 1971 - (DCSO Records Vol. 37 Page(s) 15216)

**DECLINATION 14'14"E**

**RENEWED 4/1/26**

BLM Dependent resurvey by James E. Jelley & Wayne L Rogers, Cadastral Surveyor under Group #1128 surveyed Jan. 1983- (DCSO records Vol. 43 Page(s) 16755-6)

The cor. of secs. 1 & 2 only, bears N.89°23'E., 2.29 chs. (from the CC Secs. 11 & 12) perpetuated & recorded by Tracy, in 1968, monumented with an iron post, 1 1/2" dia., firmly set, projecting 8" above ground, with brass cap (properly) mkd from which the remains of the orig. BTs

**2 1/2" BC, PROT 9"**

**NO EVIDENCE - VERY ROTTED 52" X 2 FT. STUMP**

A root hole, bears N.60°E., 58 lks. visible

**18 48**

and remains of bearing trees mkd. by Tracy

**SHATTERED ROTTED 12" X 2 FT. SNAG**

A hemlock 14" dia. bears N.57°E 38 lks. with fragmentary scribe marks visible on partially healed blaze

**25 08**

**NO EVAL**

A root hole, bears N.43°W., 38 lks with down hemlock alongside, 12" dia., with healed blaze and a new bearing tree

**21 252**

17" A hemlock 4" dia., bears N.87°W., 41 lks., mkd. X.BT.BLZ. NO LONGER VIS.

**FOUND A STEEL LATH 0 1/2 FT. NORTH**

**ADD 3 1/2" MAG NAIL R.S.C. TO ALL 4 LIVE B.T.S**

**THREE UNRECORDED, ONE OF UNKNOWN ORIGIN, OTHERS ARE 2023 WEYERHAESUR  
A 19" HEMLOCK PAINTED UP AS A B.T. BUT HAS NO BLAZE EVIDENCE; BEARS  
N 58°E, 33 1/4 FT. DISTANT.**

**A 6" D. FIR SCRIBED "S 11 BT" ON A SINGLE BLZ.; BEARS N 83°E, 32 3/4 FT DISTANT**

**2023 WEYERHAESUR TAG ON TREE SAYS S 83°W, 23 1/2 FT. (COULD BE TRANSPOSED)**

**A 7" D. FIR SCRIBED "1/4 S 1 BT" ON A SINGLE BLZ.; BEARS S 51°W 22 1/2 FT DISTANT.  
2023 WEYERHAESUR TAG ON TREE SAYS "N 51°E, 21 1/2 FT.**

**CORNER MONUMENT IS ON MODERATE NORTH SLOPE IN OLDER REGRDUTH FOREST. MONUMENT IS APPROX 55 FT NORTH FROM A DIRT ROAD.**

**CS 67/02-37 pg 3/3**