



PLAN	DATE
BY	
CHECKED	
DATE	
NO.	

PROFILE	DATE
BY	
CHECKED	
DATE	
NO.	

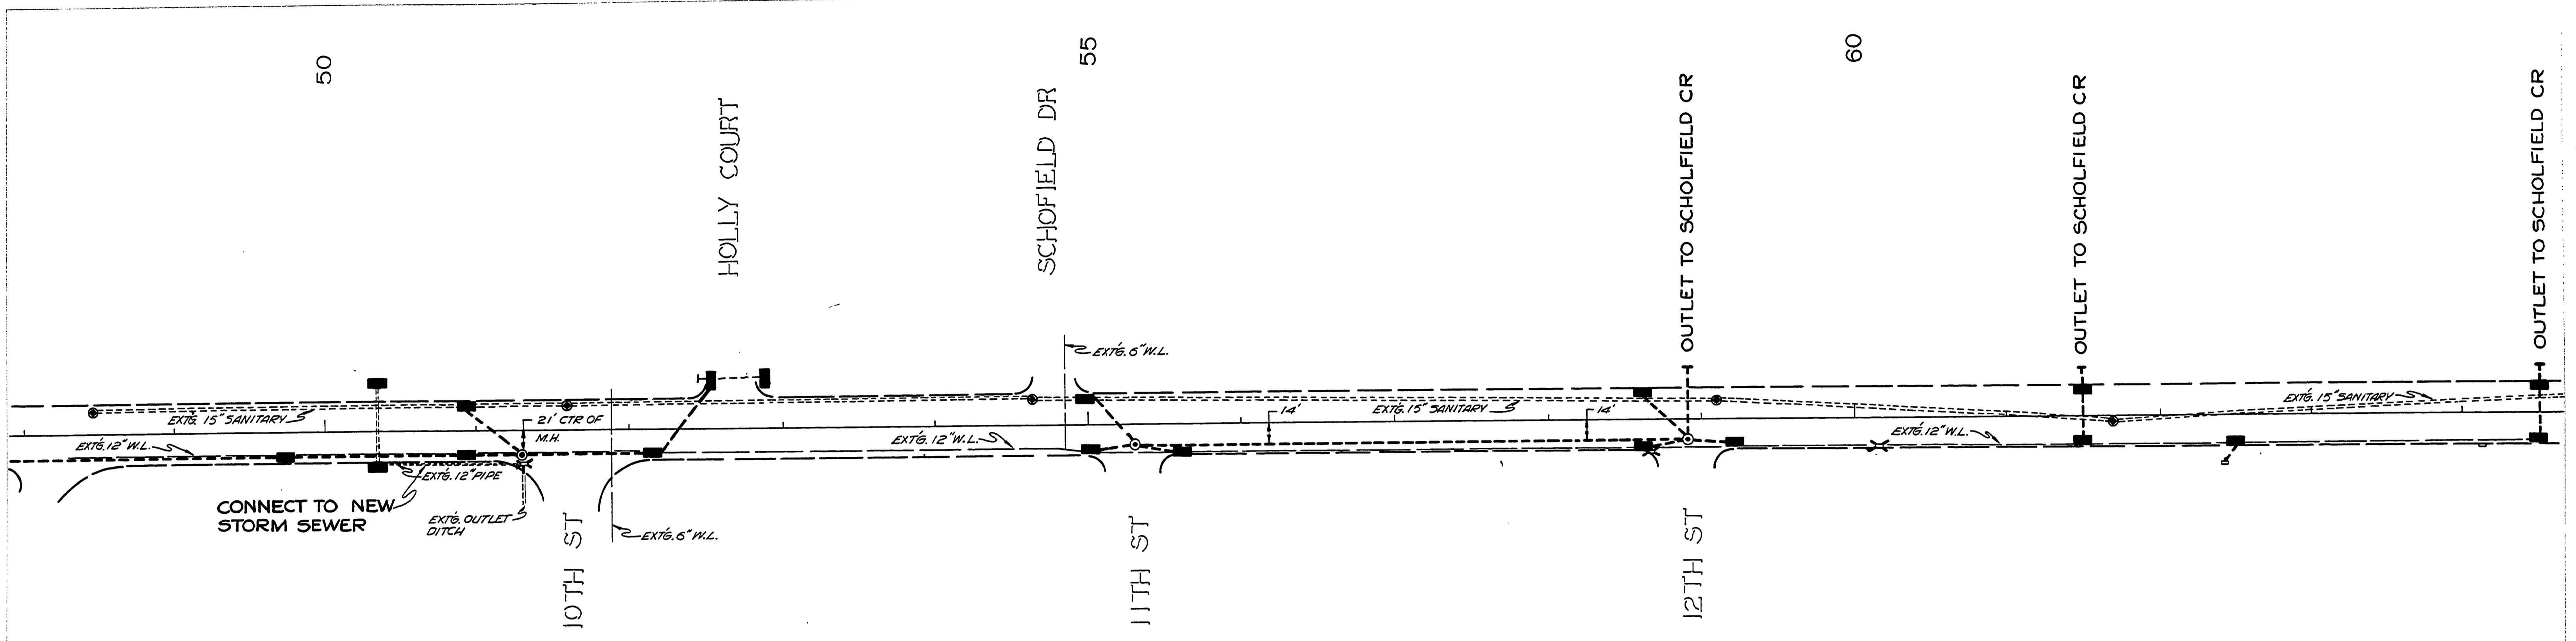

NOTE: DIMENSIONS SHOWN ARE EITHER IN REFERENCE TO THE C.B. \bar{C} OR THE PIPE \bar{E} .

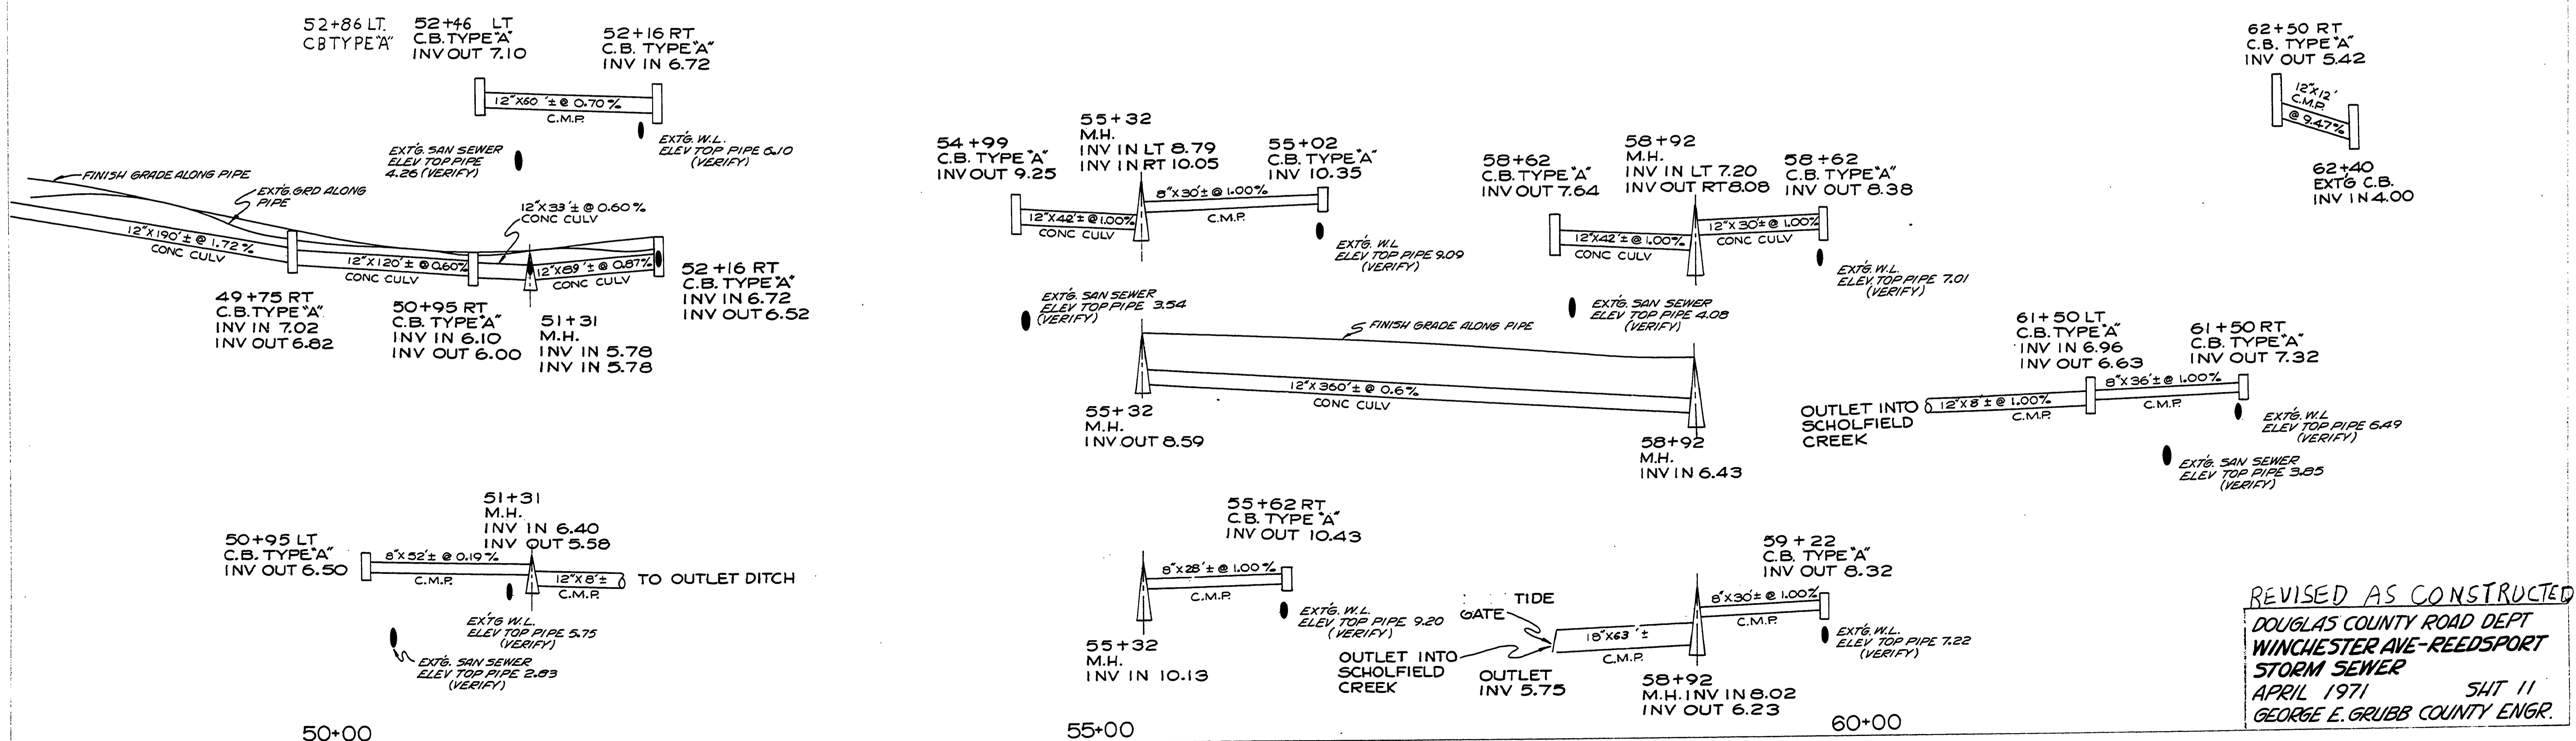

REVISED AS CONSTRUCTED
 DOUGLAS COUNTY ROAD DEPT
 WINCHESTER AVE-REEDSPORT
 STORM SEWER
 APRIL 1971
 SHIT 11
 GEORGE E. GRUBB COUNTY ENGR.