


PROFILE SYMBOLS
 EXISTING PIPE
 12" CULV PIPE
 TO BE INSTALLED

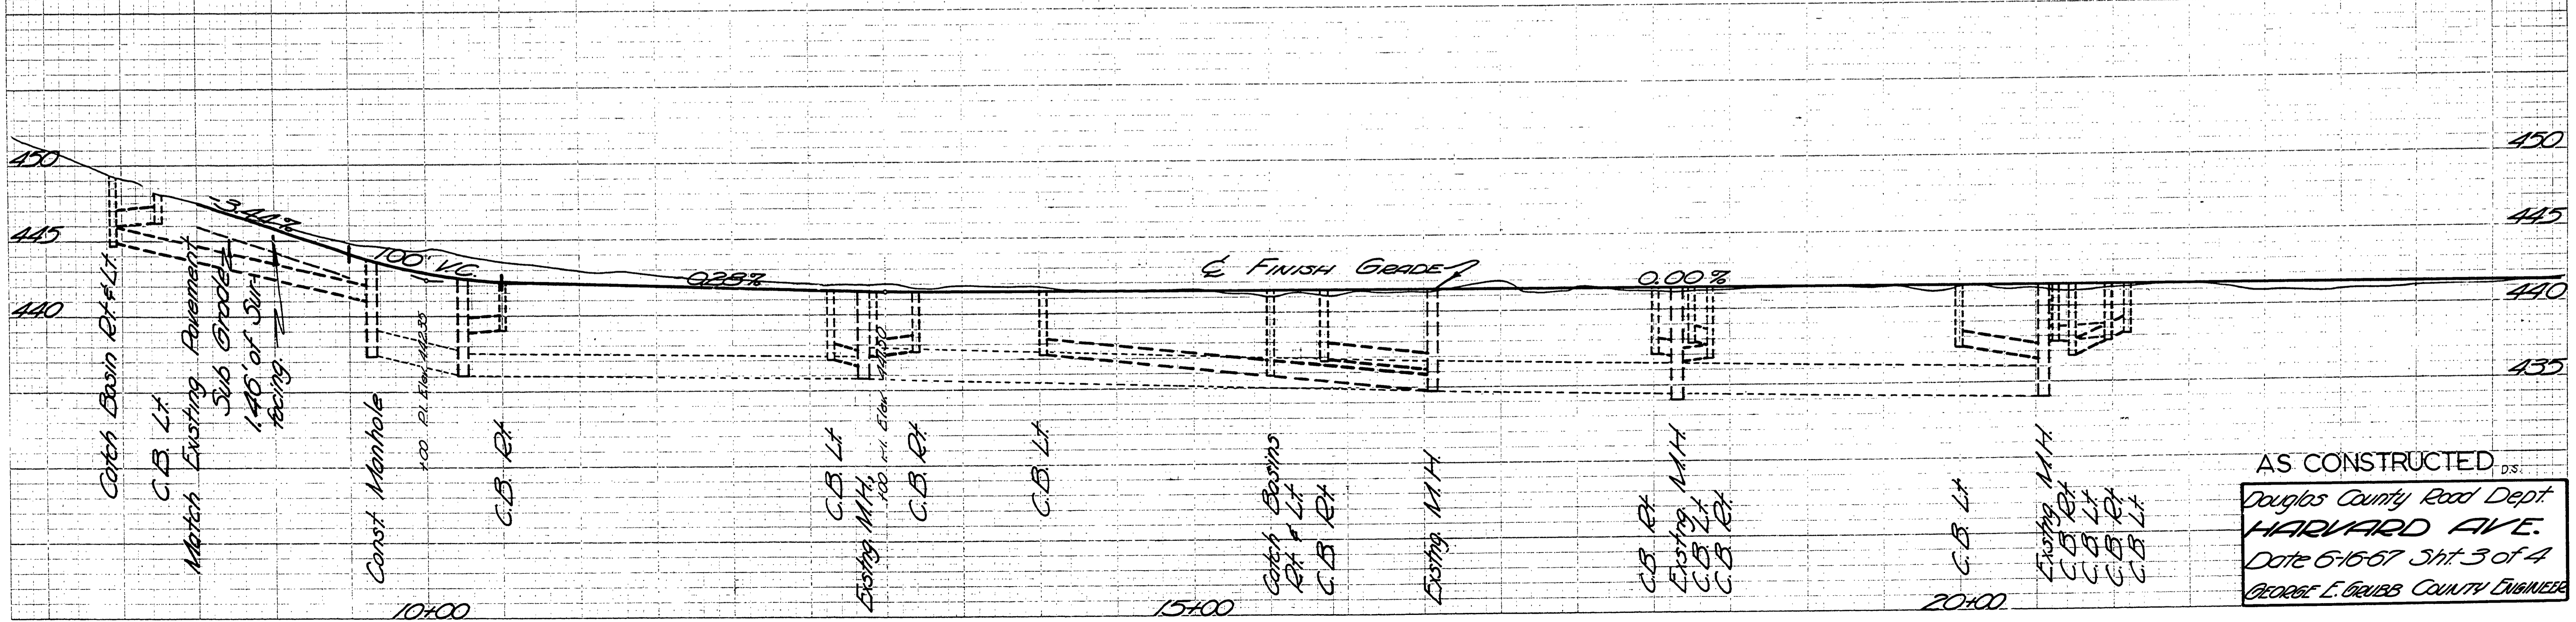

AS CONSTRUCTED D.S.
 Douglas County Road Dept.
HARVARD AVE.
 Date 6-16-67 Shit. 3 of 4
 GEORGE E. GRIFFIN COUNTY ENGINEER

DATE
 BY
 SURVEYED
 SURVEY
 NOTE BOOK
 PLANS CHECKED

DATE
 BY
 SURVEYED
 SURVEY
 NOTE BOOK
 PLANS CHECKED