
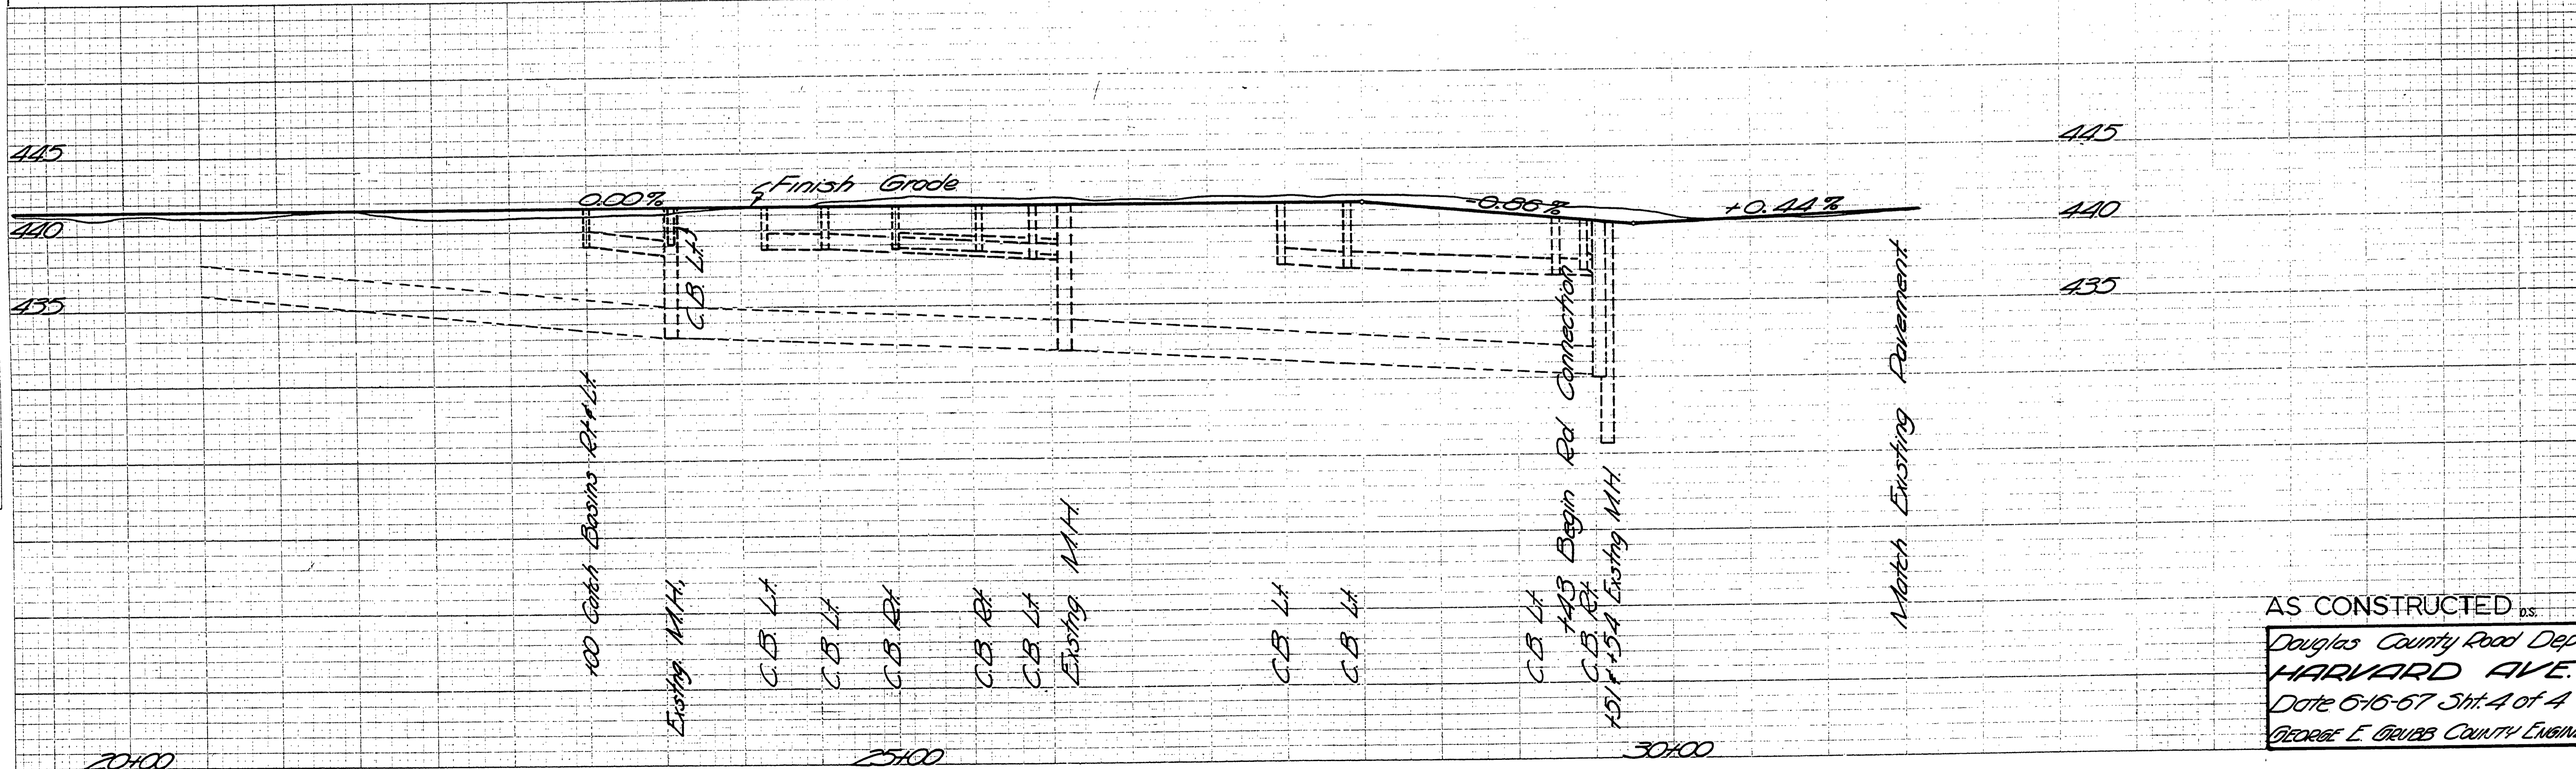


DATE \_\_\_\_\_ BY \_\_\_\_\_  
 REVISIONS:  
 1. \_\_\_\_\_  
 2. \_\_\_\_\_  
DATE \_\_\_\_\_ BY \_\_\_\_\_  
 REVISIONS:  
 1. \_\_\_\_\_  
 2. \_\_\_\_\_  
 3. \_\_\_\_\_  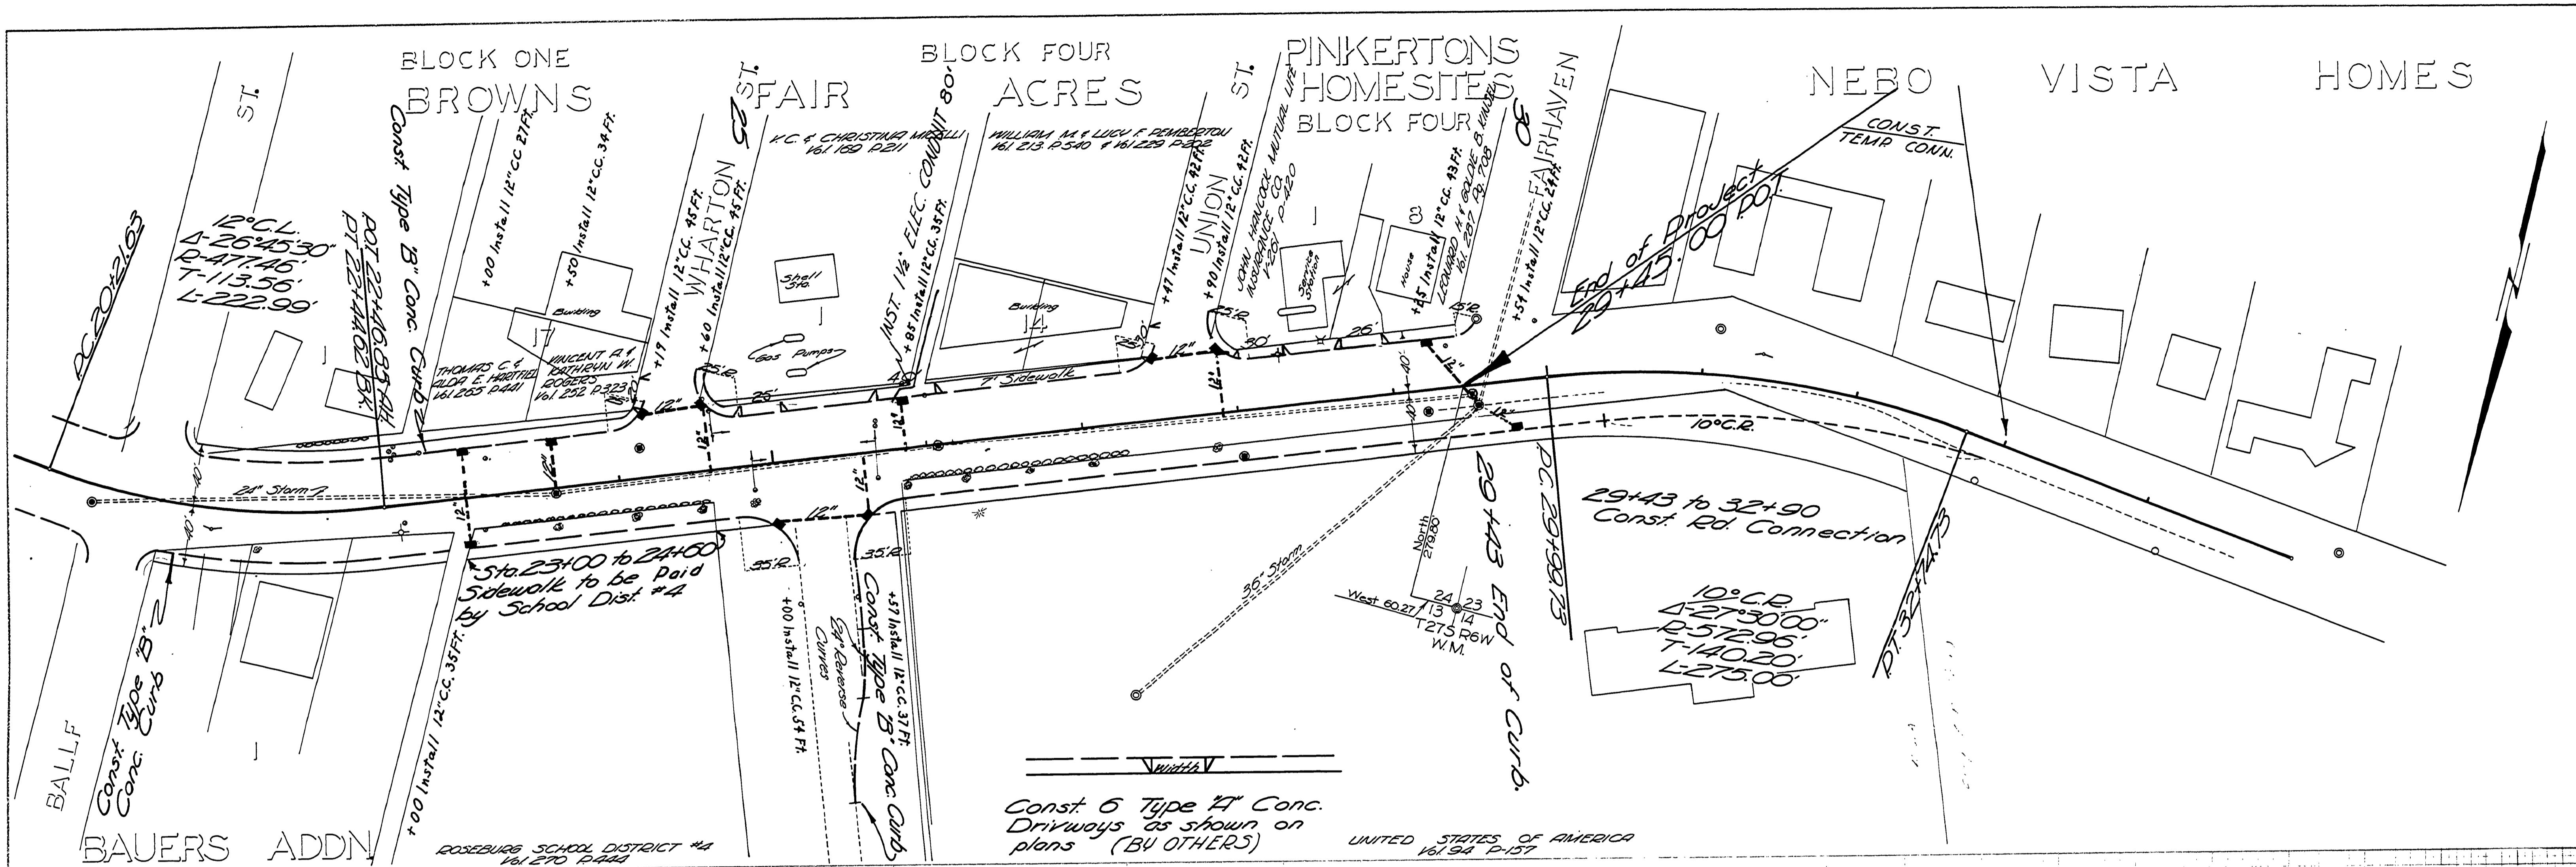
AS CONSTRUCTED BY  
 Douglas County Road Dept.  
 HARVARD AVE.  
 Date 6-16-67 Sht. 4 of 4  
 GEORGE E. DOUGLAS COUNTY ENGINEER