


# SEC. 19 T27S R5W WM

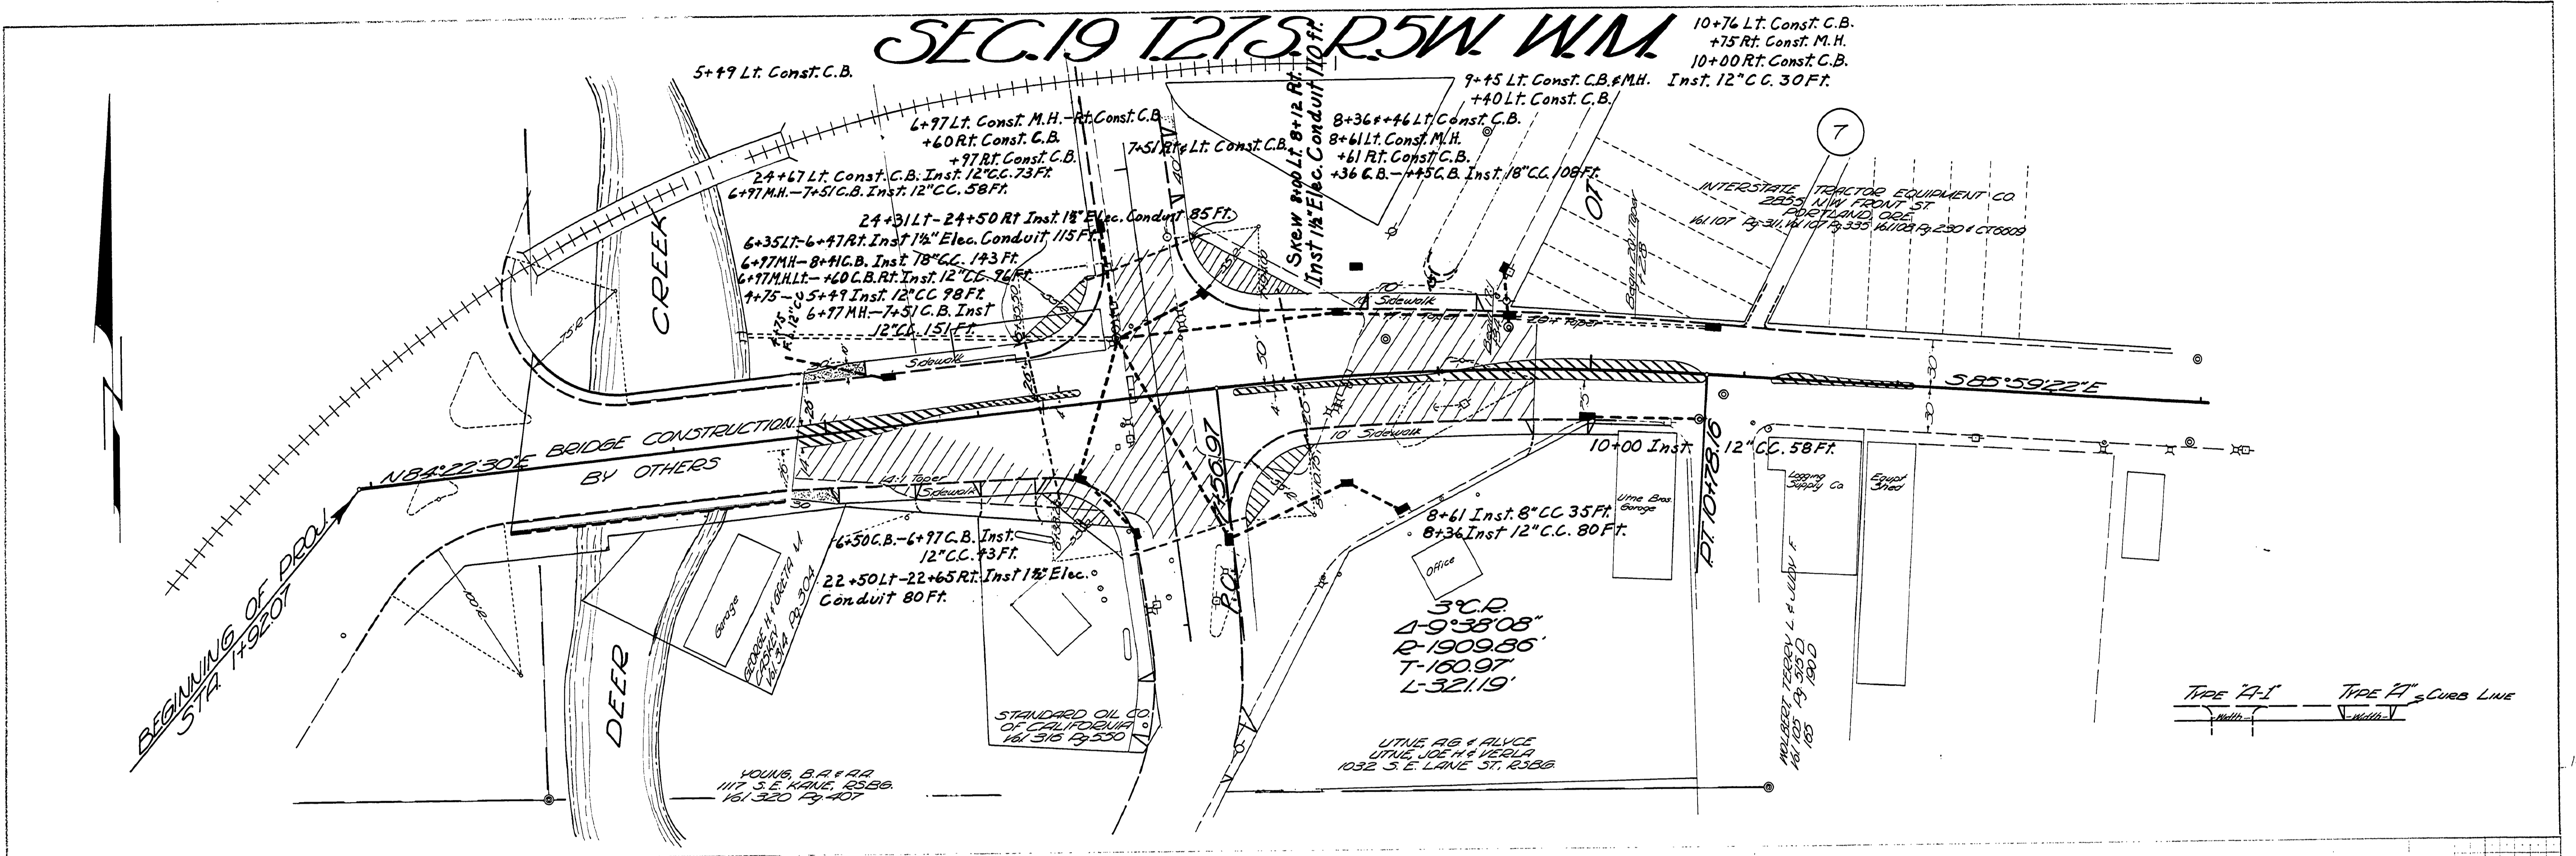

DATE	BY
SWAYED	PLOTTED
NOTED	APPROVED
DATE	BY
DATE	BY

