




# Jefferson St.

## STREET IMPROVEMENT PROJECT

IN "GARDEN HOMES SUBDIVISION"  
ROSEBURG, OREGON

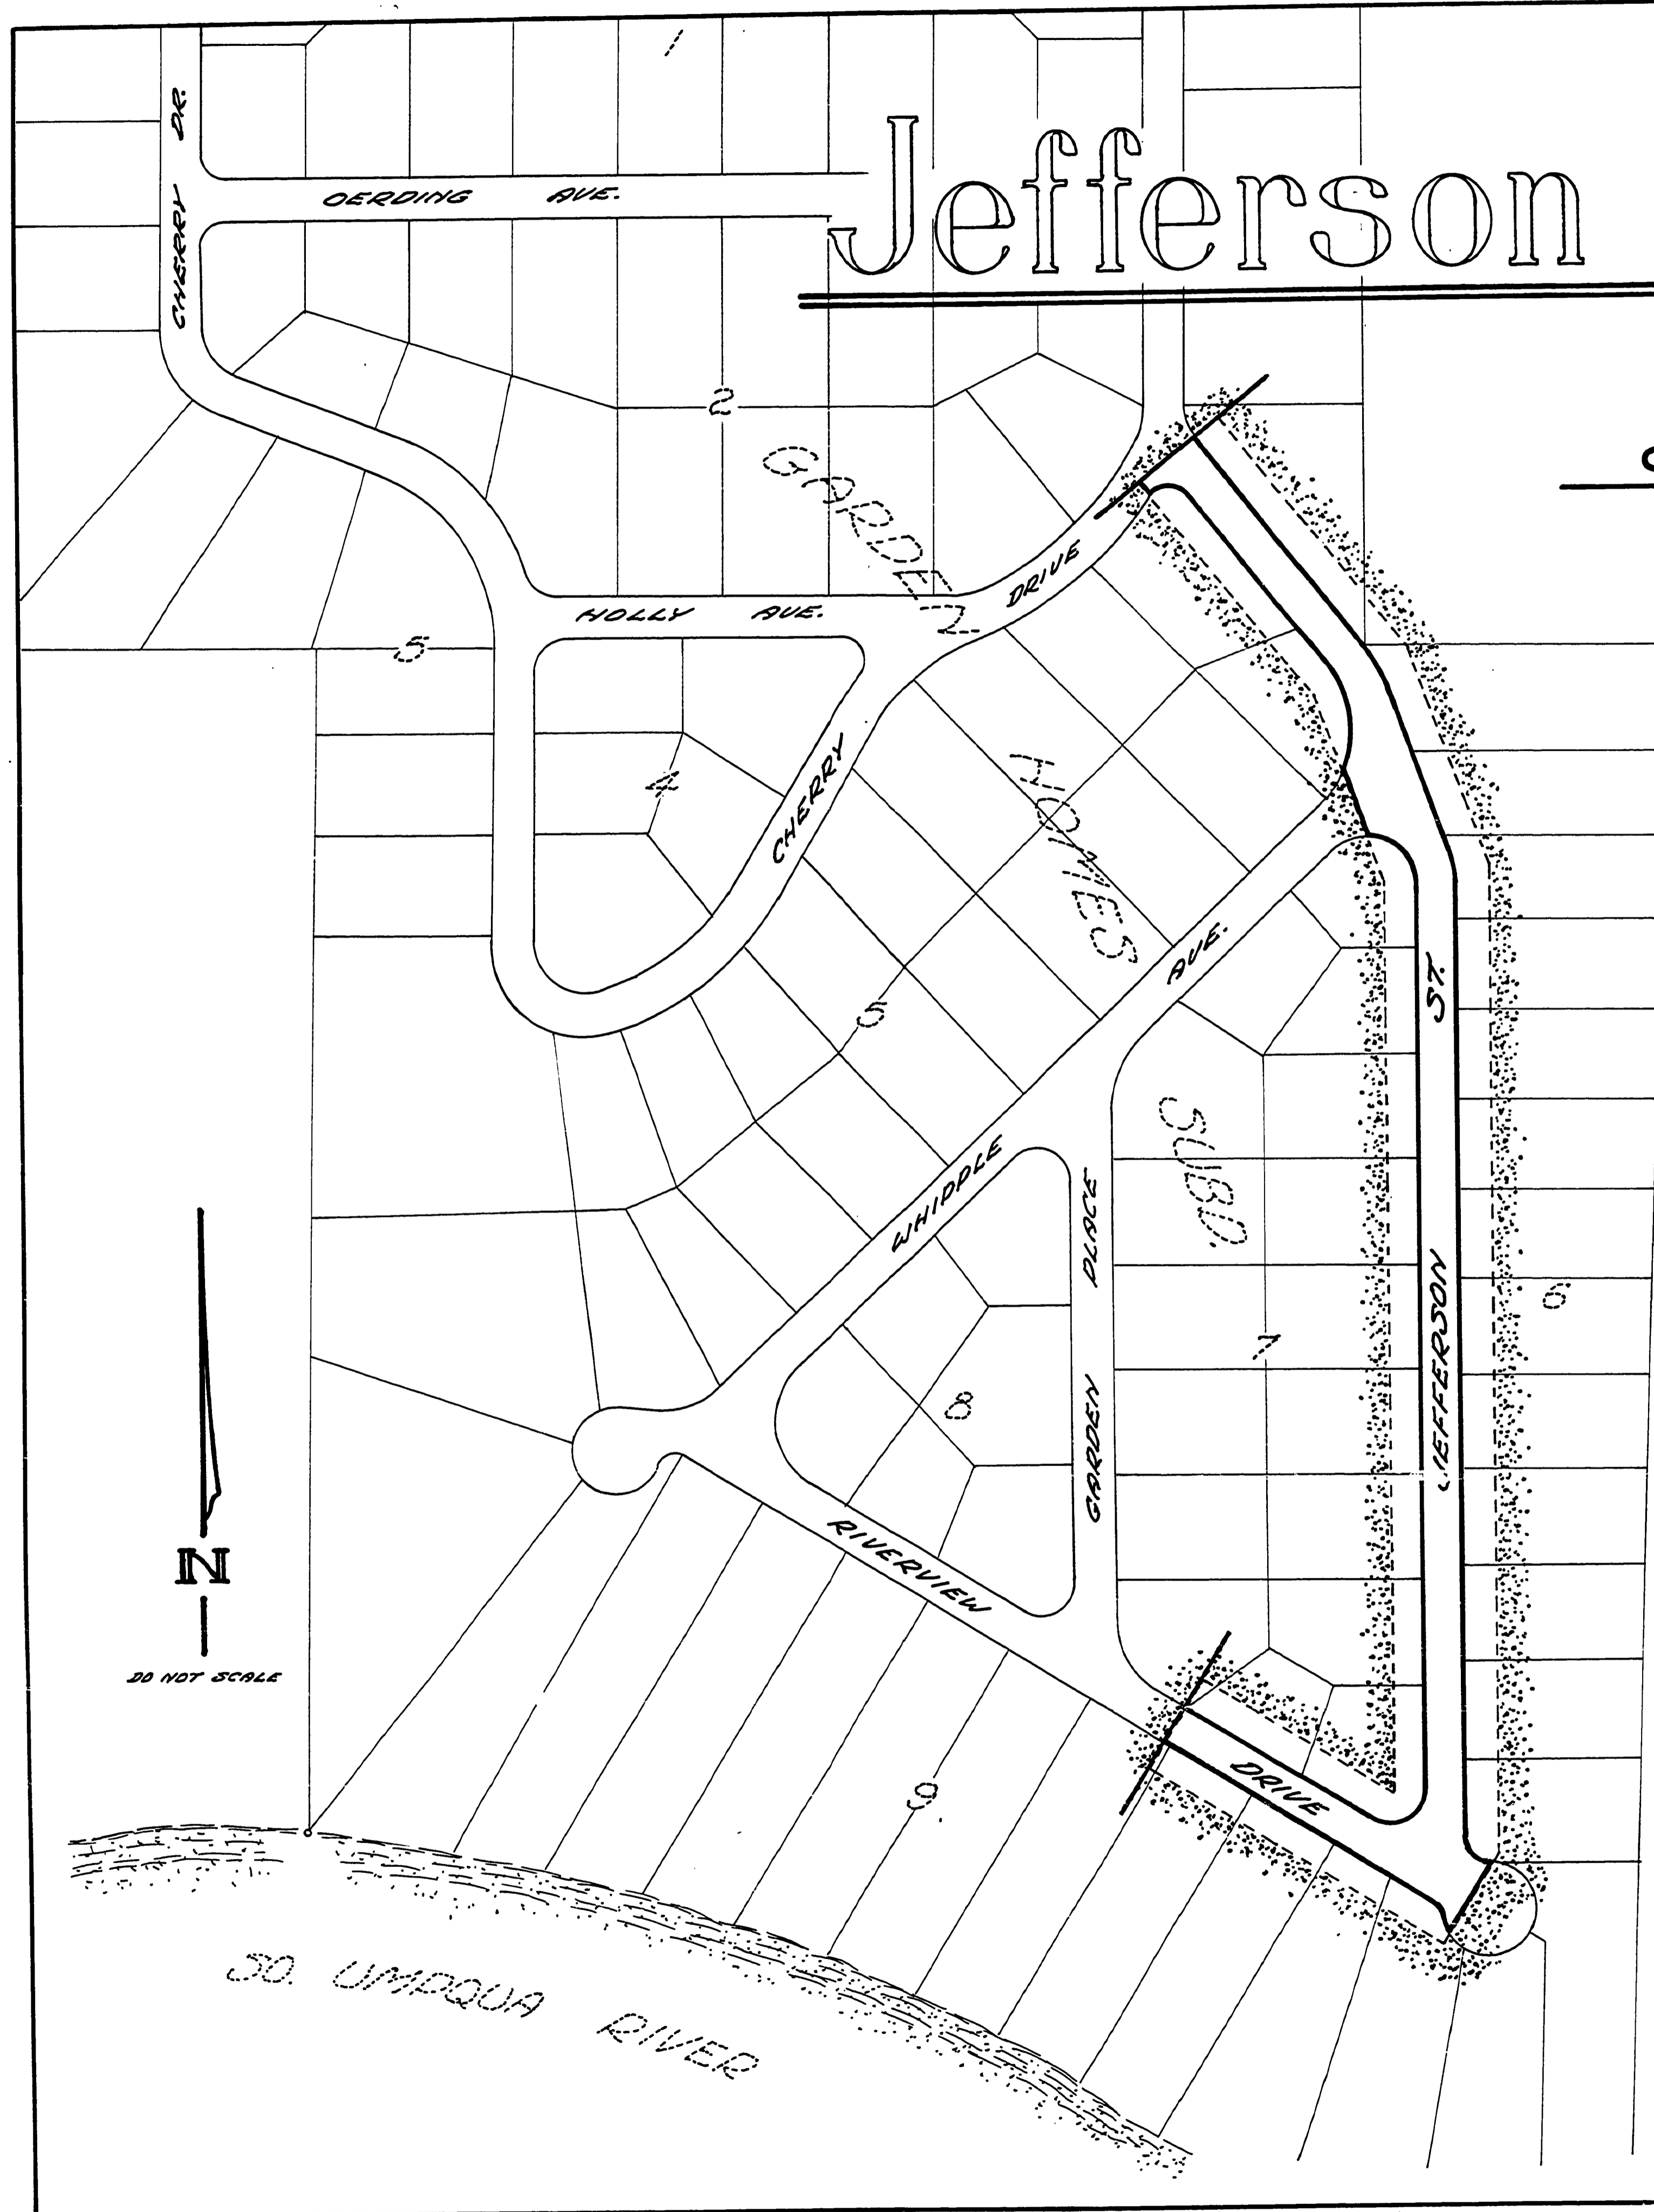

DO NOT SCALE

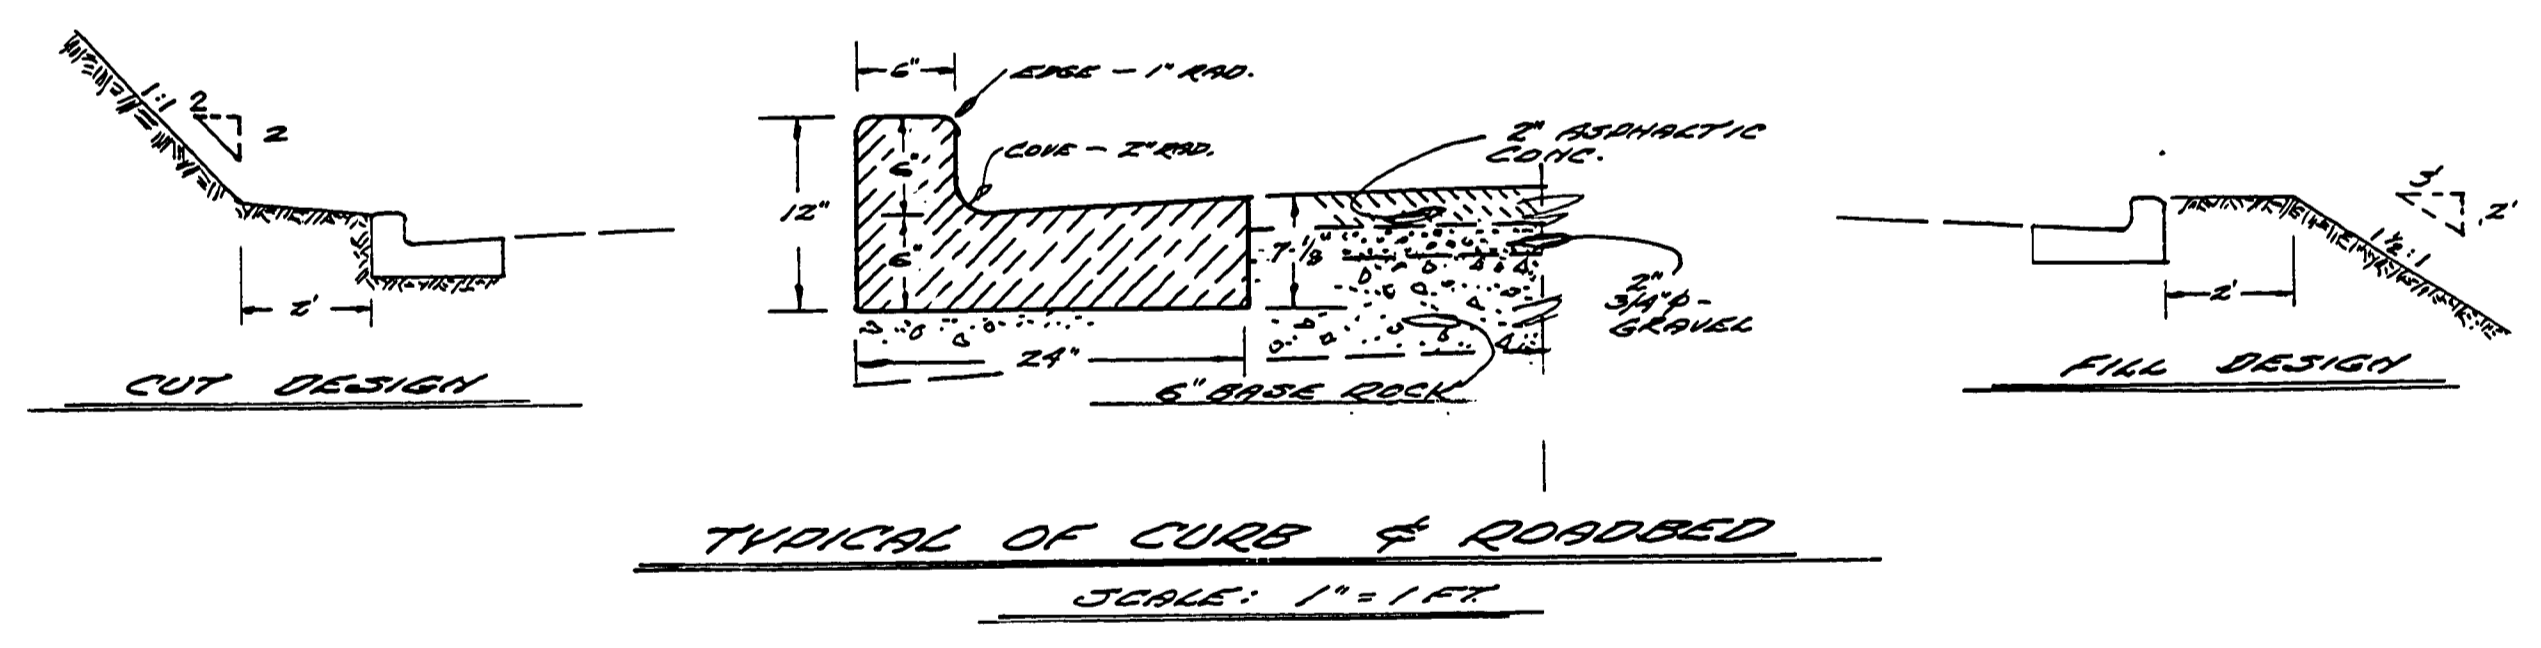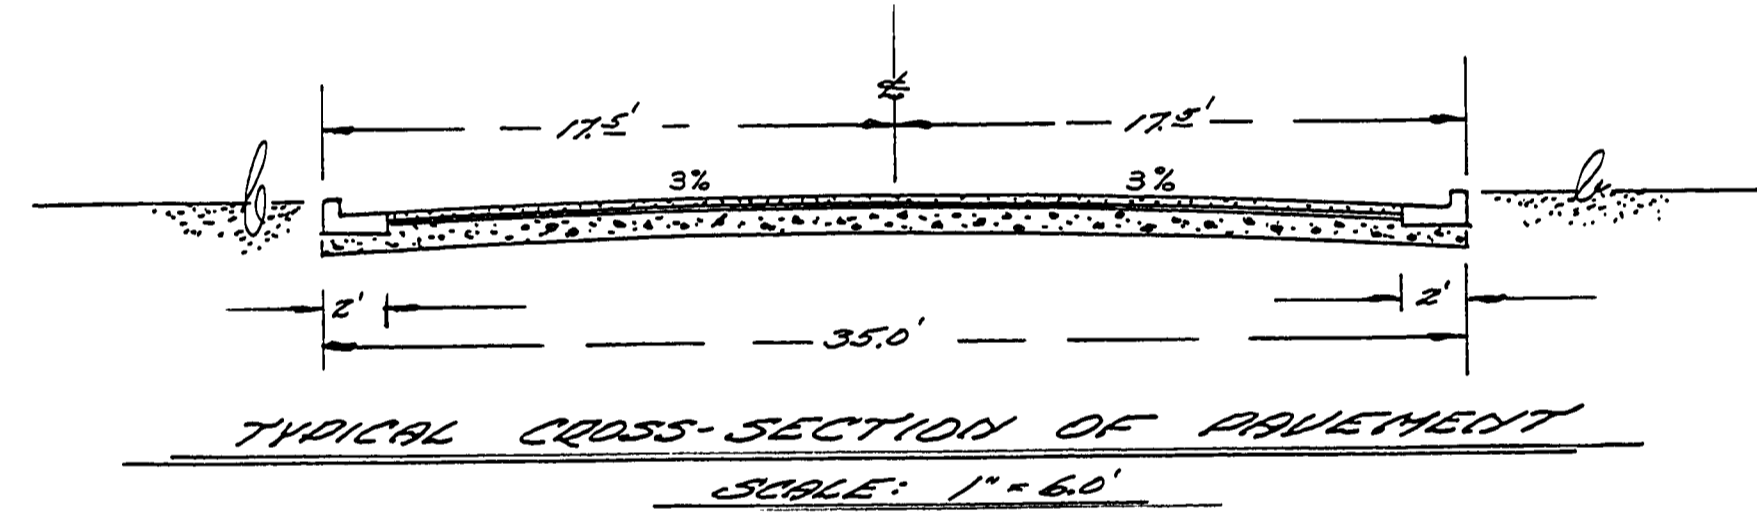

8-21-74 FILE DATE REVISED AS BUILT P.H.	
CITY OF ROSEBURG DEPT. OF PUBLIC WORKS ROSEBURG, ORE.	
DRAWN: BY: J.L.L.	JEFFERSON ST. STREET IMPROVEMENT PROJECT
DESIGNED: J.C.	
CHECKED:	
DATE: MAY 1971	SHEET #1 OF 9 SHEETS
REV: MAY 9, 1972	
NOTE:	