


# JEFFERSON ST. STREET IMPROVEMENT PROJECT

## STORM LINE


N  
PLAN SCALE: 1"=20'

NOTE: SANITARY SEWER TIES TO PROPERTY LINE ALONG THE EAST SIDE OF JEFFERSON ST.

PLAN	DATE
BY	
REVISIONS	
NO.	
DATE	
BY	
REVISIONS	
NO.	
DATE	
BY	
REVISIONS	
NO.	
DATE	

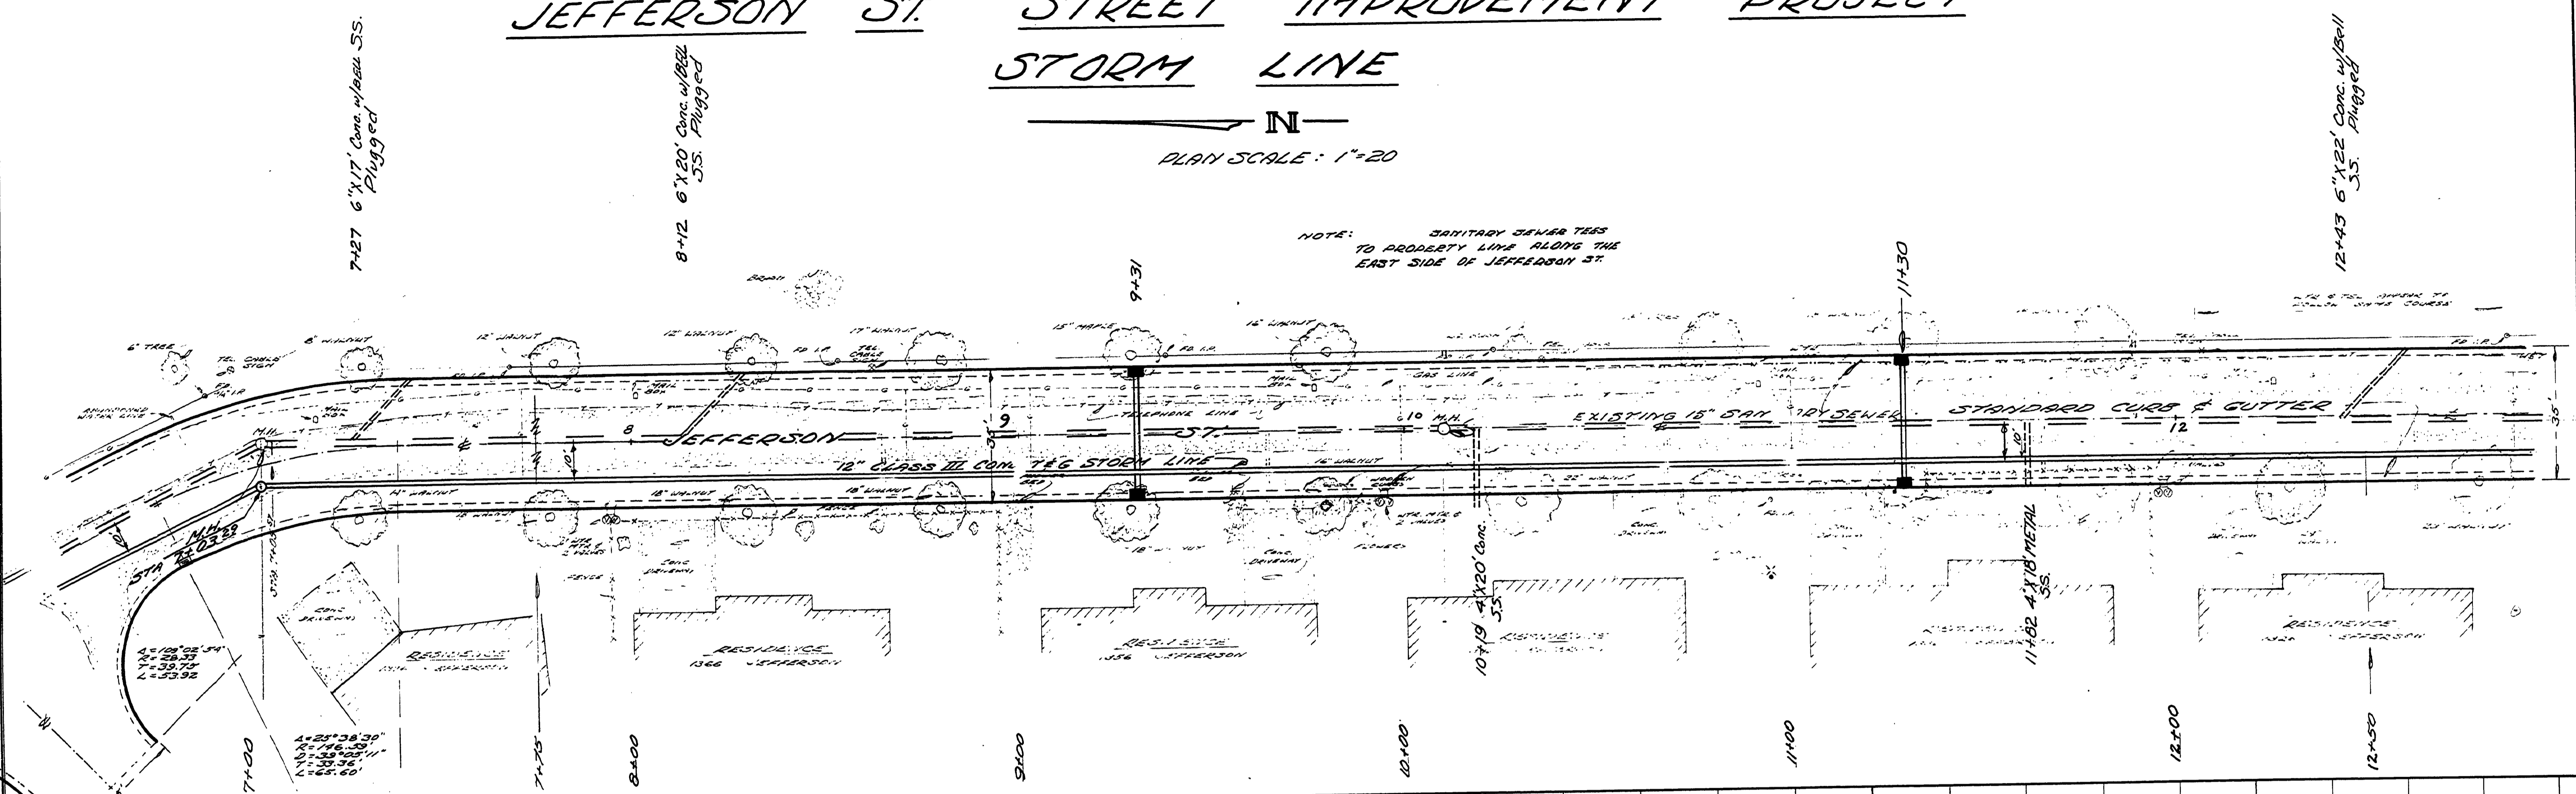

PROFILE	DATE
BY	
REVISIONS	
NO.	
DATE	
BY	
REVISIONS	
NO.	
DATE	

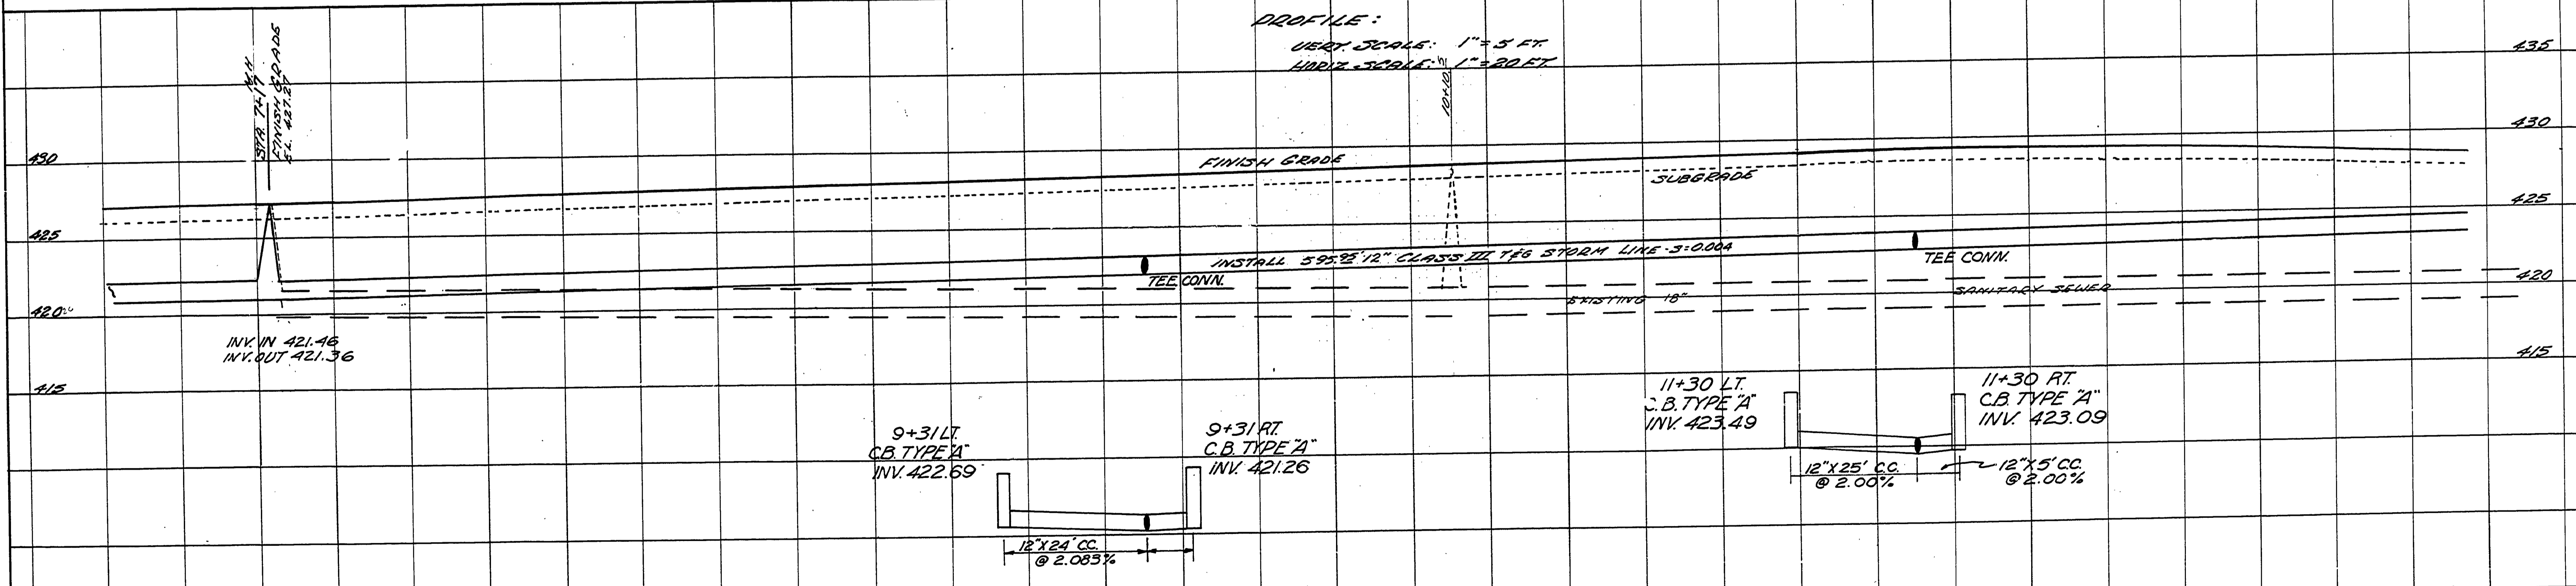

8-21-74 FILE DATE  
REVISED AS BUILT P.H.

**JEFFERSON ST.**  
STREET IMPROVEMENT  
PROJECT  
SHEET #7 OF 9 SHEETS