
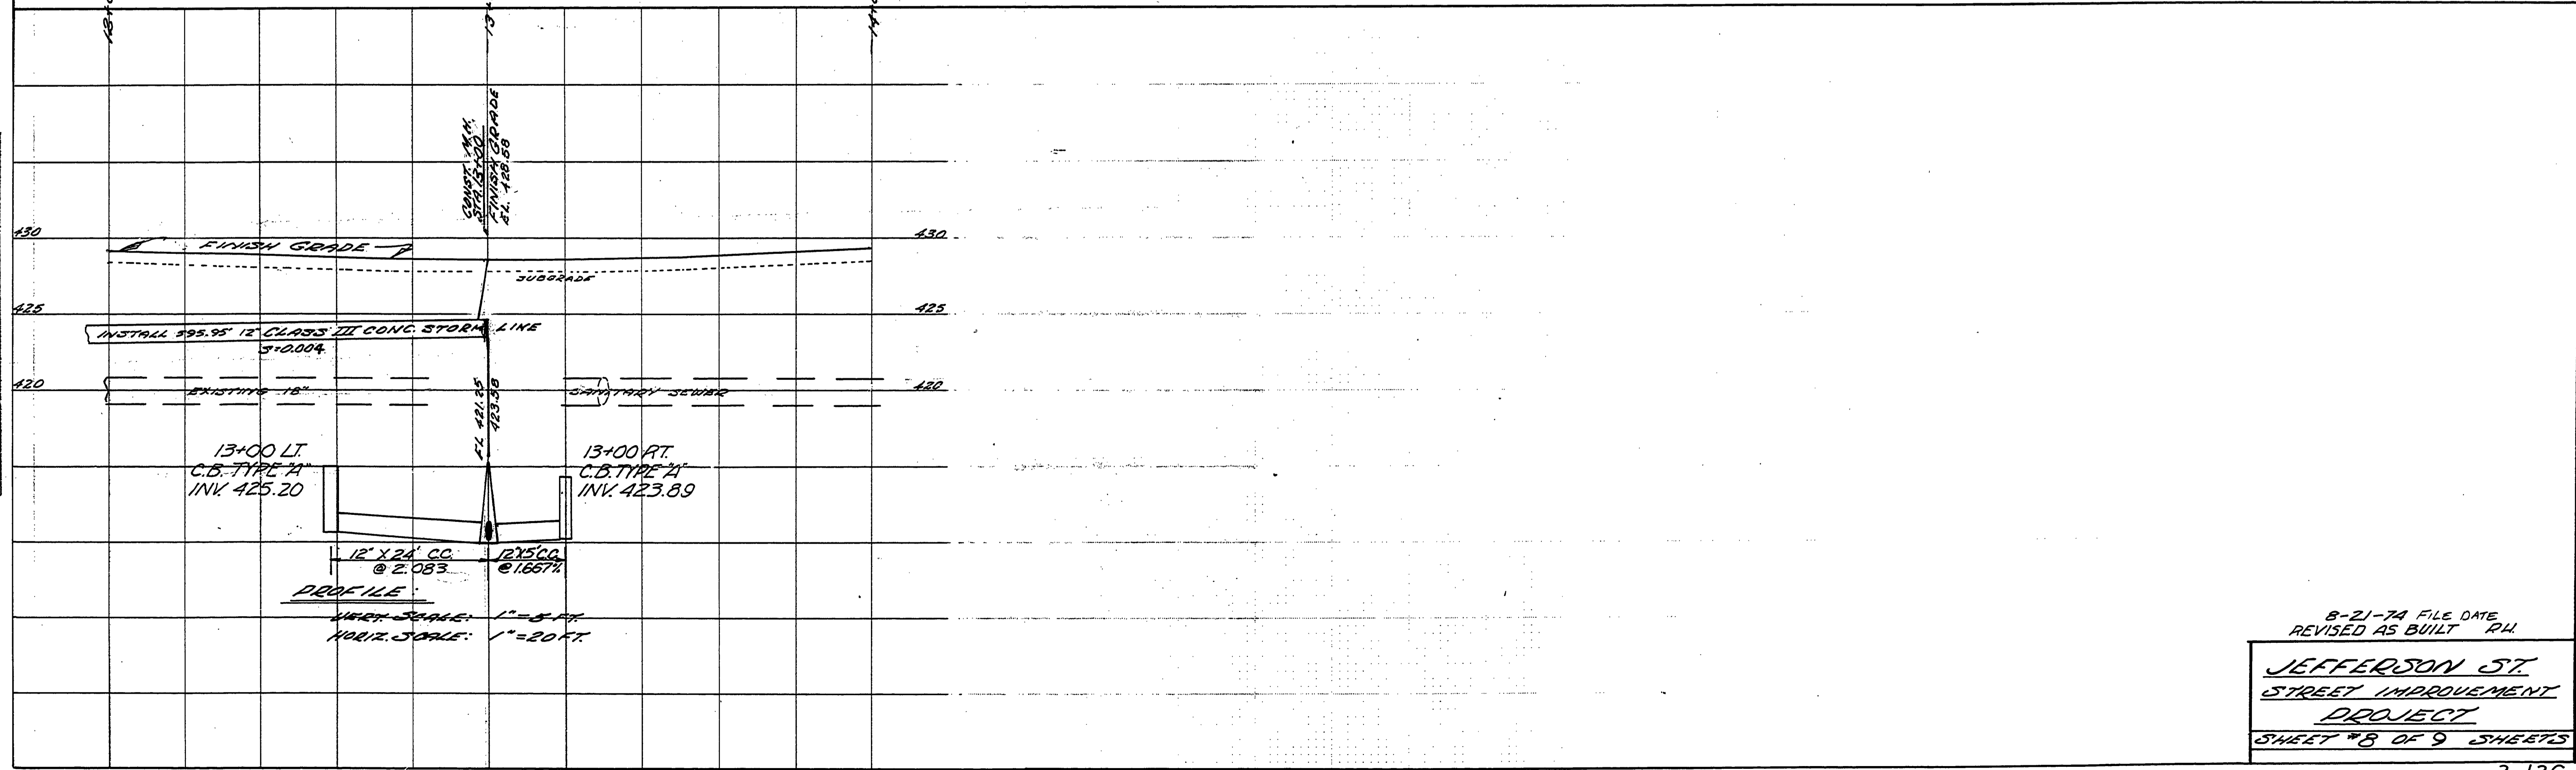


JEFFERSON ST. STREET IMPROVEMENT PROJECT

STORM LINE

PLAN	DATE	
	BY	
NO.	DATE	
	BY	
SURVEYED PLOTTED CHECKED BY		
NOTE BOOK NO.		

PROFILE	DATE	
	BY	
NO.	DATE	
	BY	
SURVEYED PLOTTED CHECKED BY		
NOTE BOOK NO.		

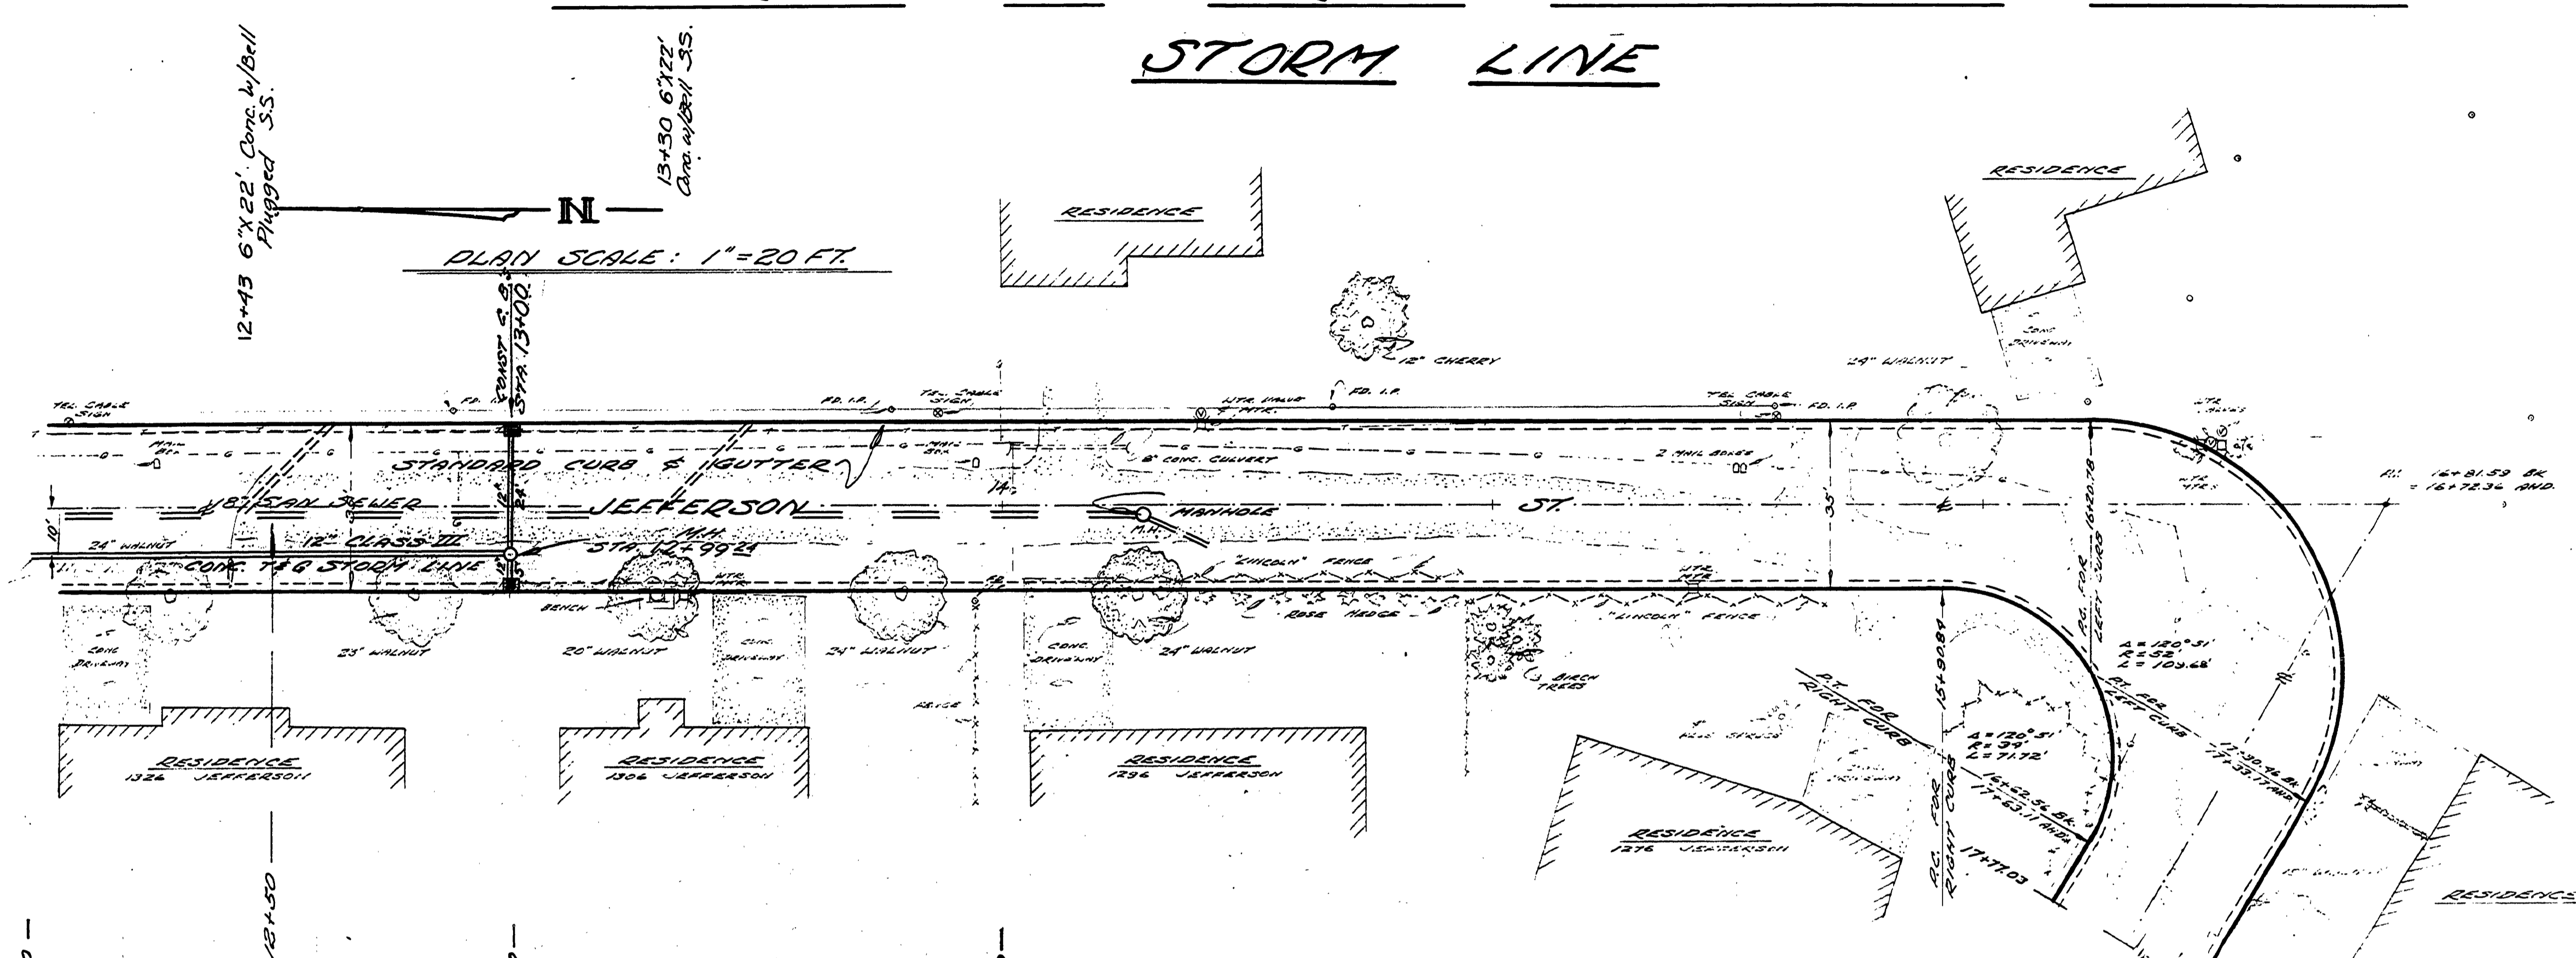

8-21-74 FILE DATE
 REVISED AS BUILT R/H

**JEFFERSON ST.
 STREET IMPROVEMENT
 PROJECT**

SHEET #8 OF 9 SHEETS