


DOUGLAS COUNTY, OREGON

PLANS FOR PROPOSED PROJECT

GRADING & SURFACING

OAK AVENUE BRIDGE PROJECT

REVISED AS BUILT P.H.
8-22-74 FILE DATE

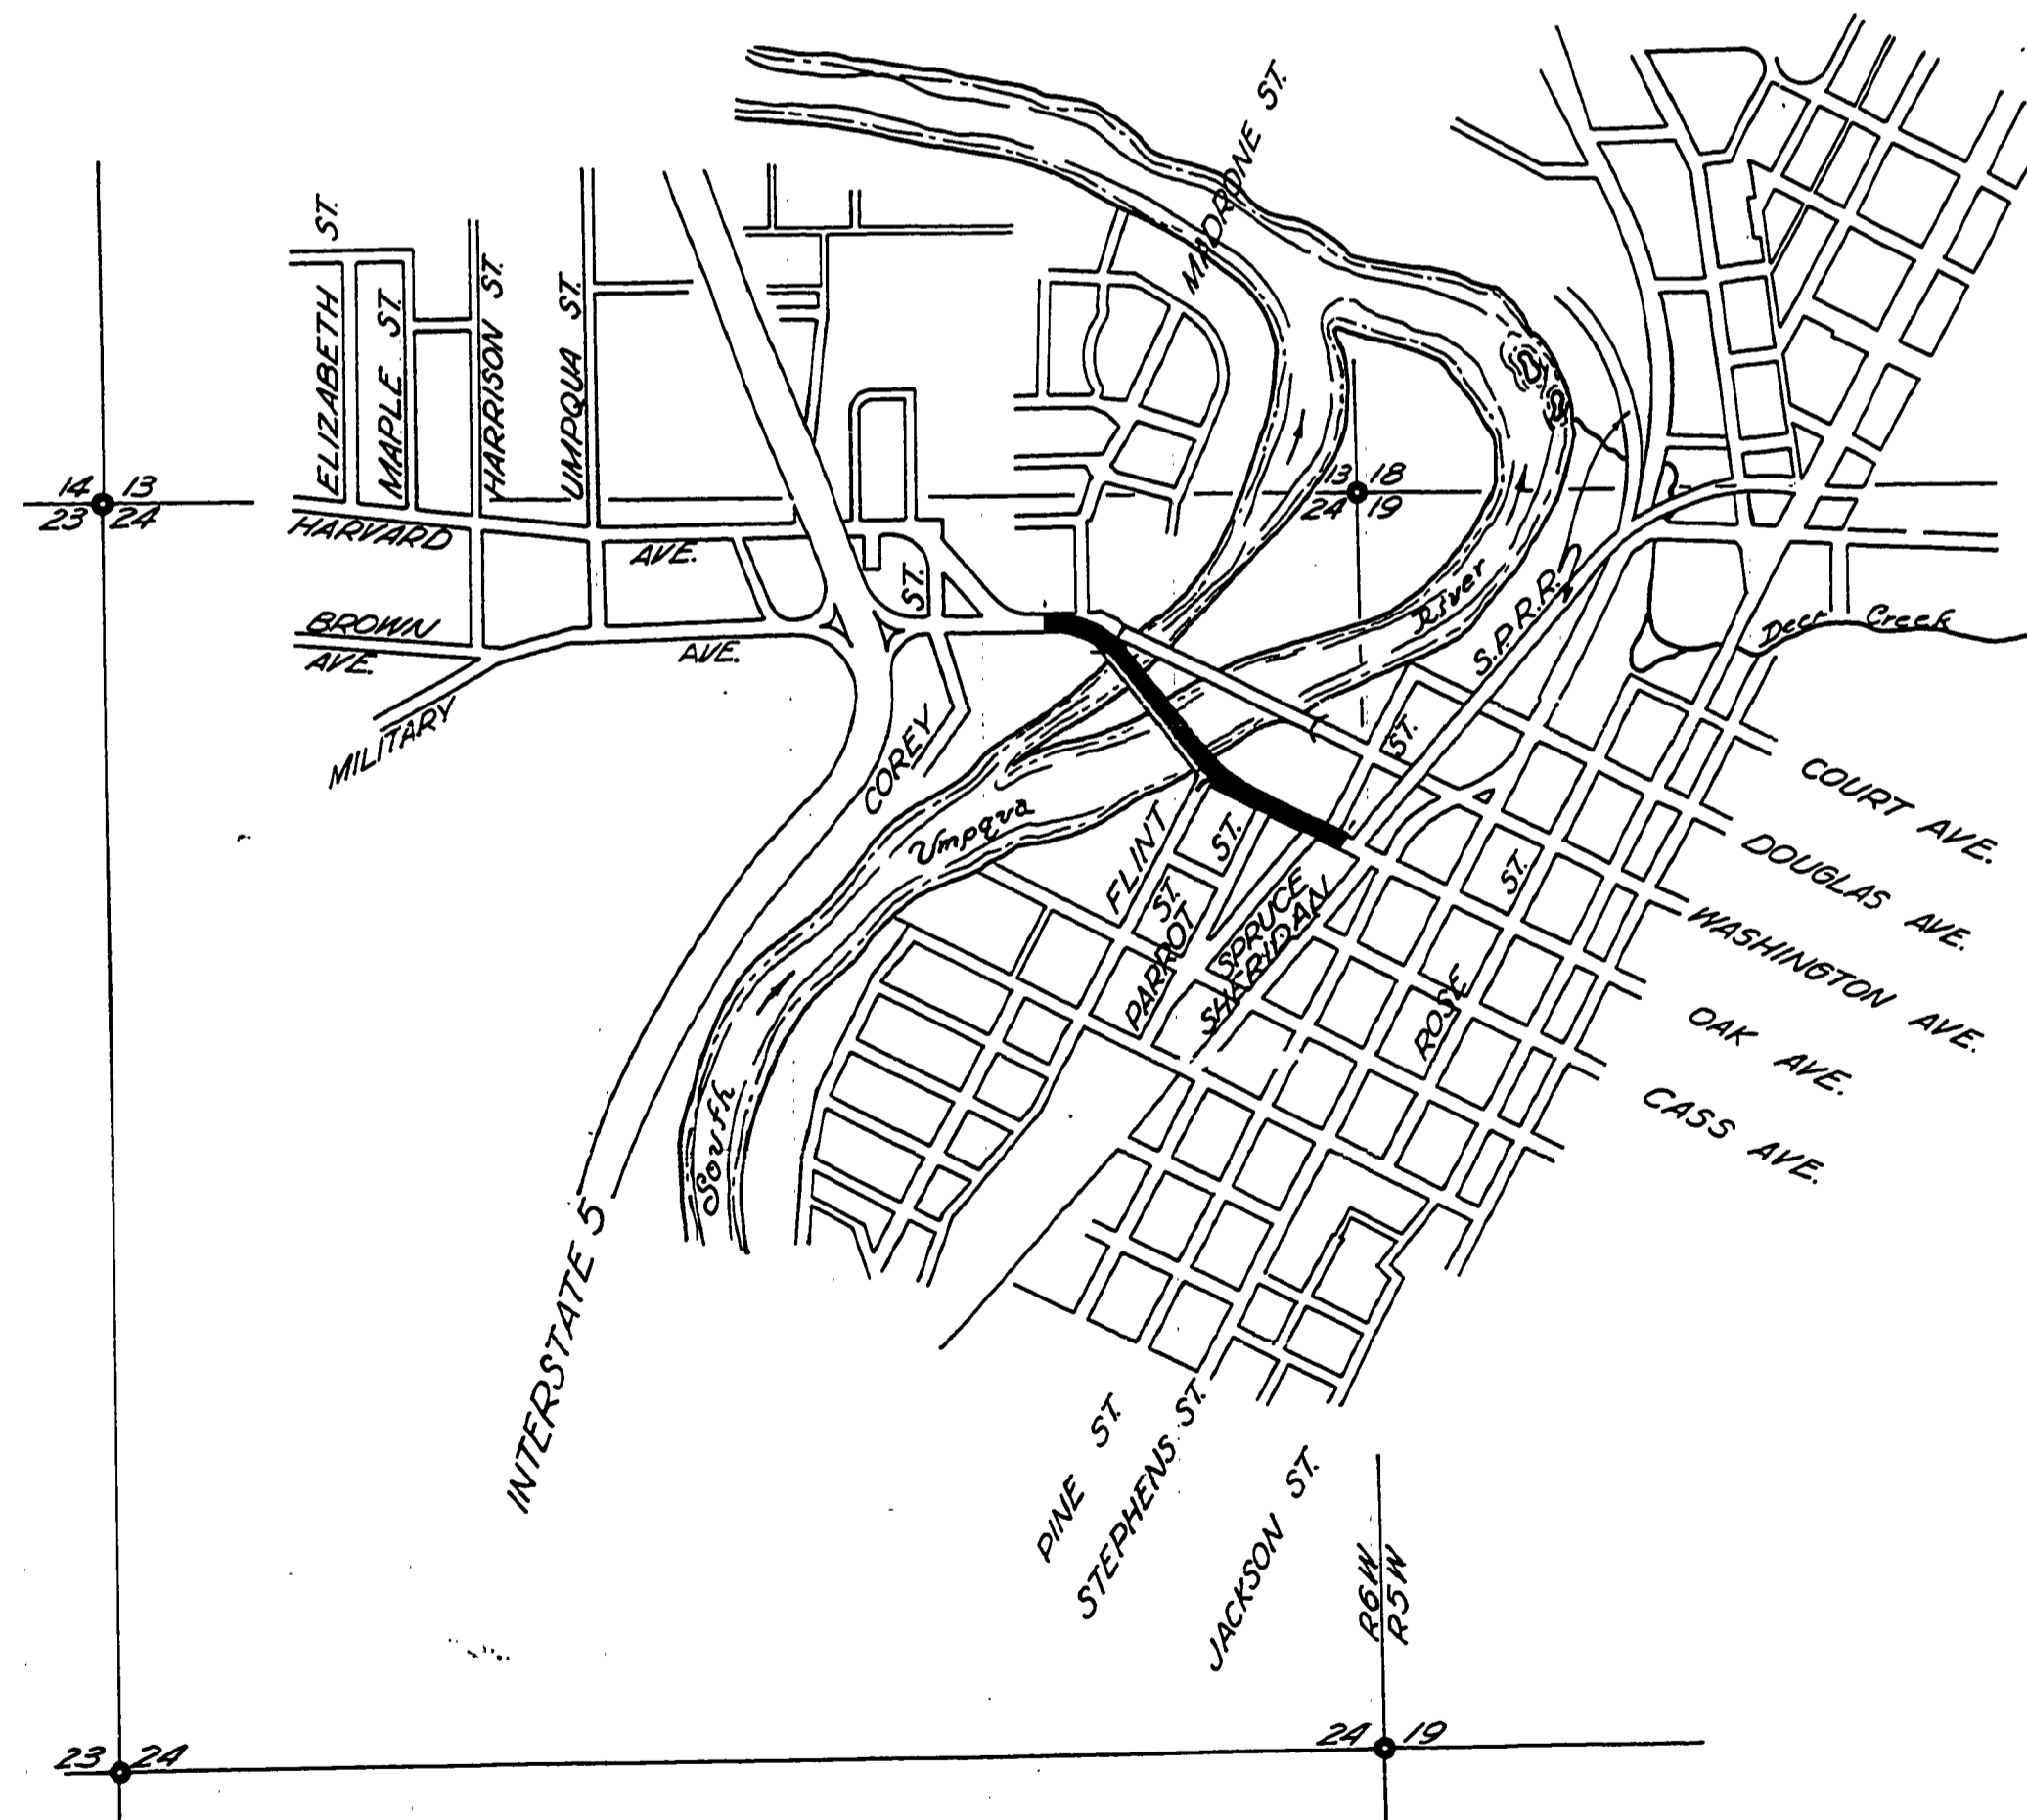

INDEX OF DRAWINGS

SHEET NUMBER	TITLE
1	TITLE SHEET
2	QUANTITY SUMMARY
3	TYPICAL SECTIONS
4	PIPE LIST
5	STAIRWAY TYPICALS
6	RETAINING WALLS & HANDRAIL
7 & 8	ROAD PLANS
9 & 10	STORM SEWER PLANS
11	CUL-DE-SAC PLAN & PROFILE
12	CONC. ISLAND PLAN

STD DWGS
1,2,3,4 & 9

TOTAL OF 17 SHTS



DOUGLAS COUNTY ROAD DEPT.
OAK AVENUE BRIDGE PROJECT
1972 SHT 1
GEORGE E. GRUBB COUNTY ENG.