
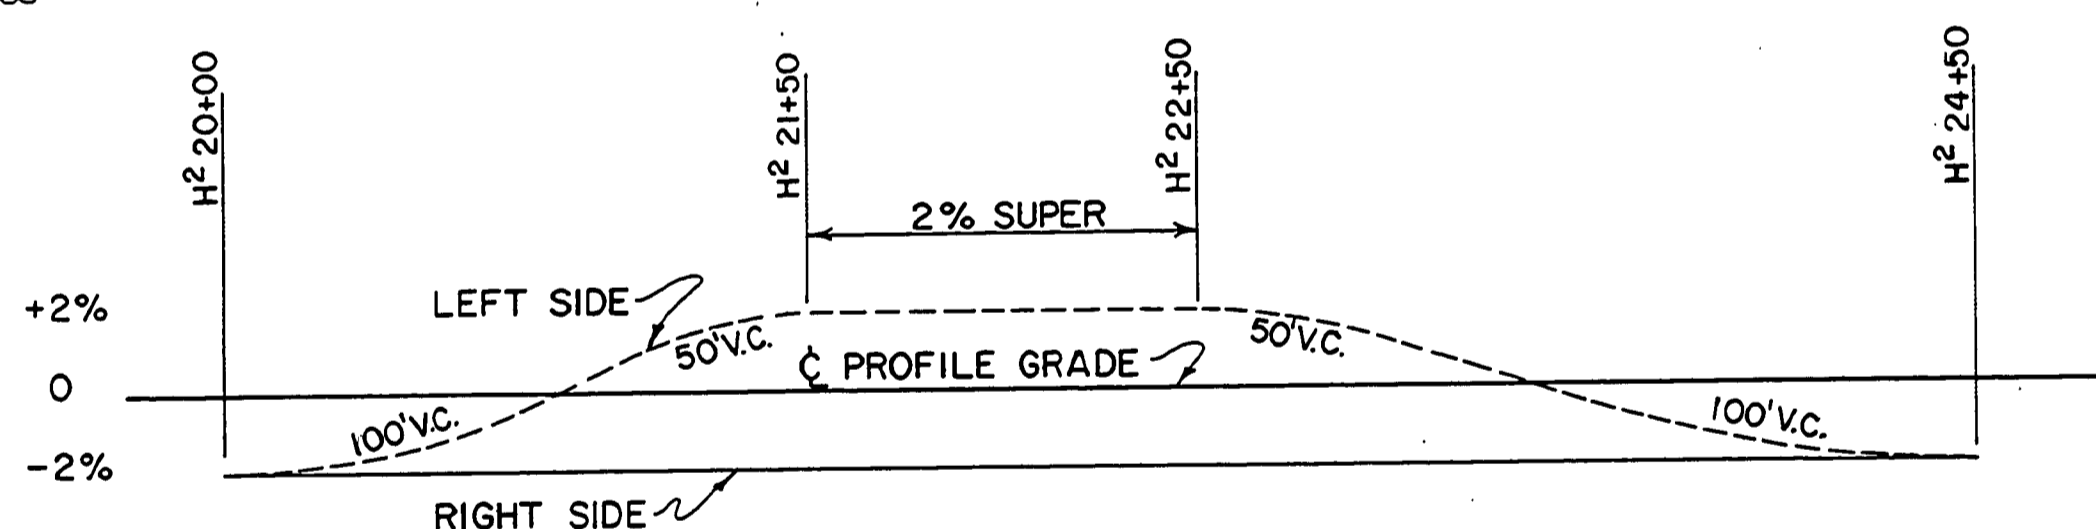
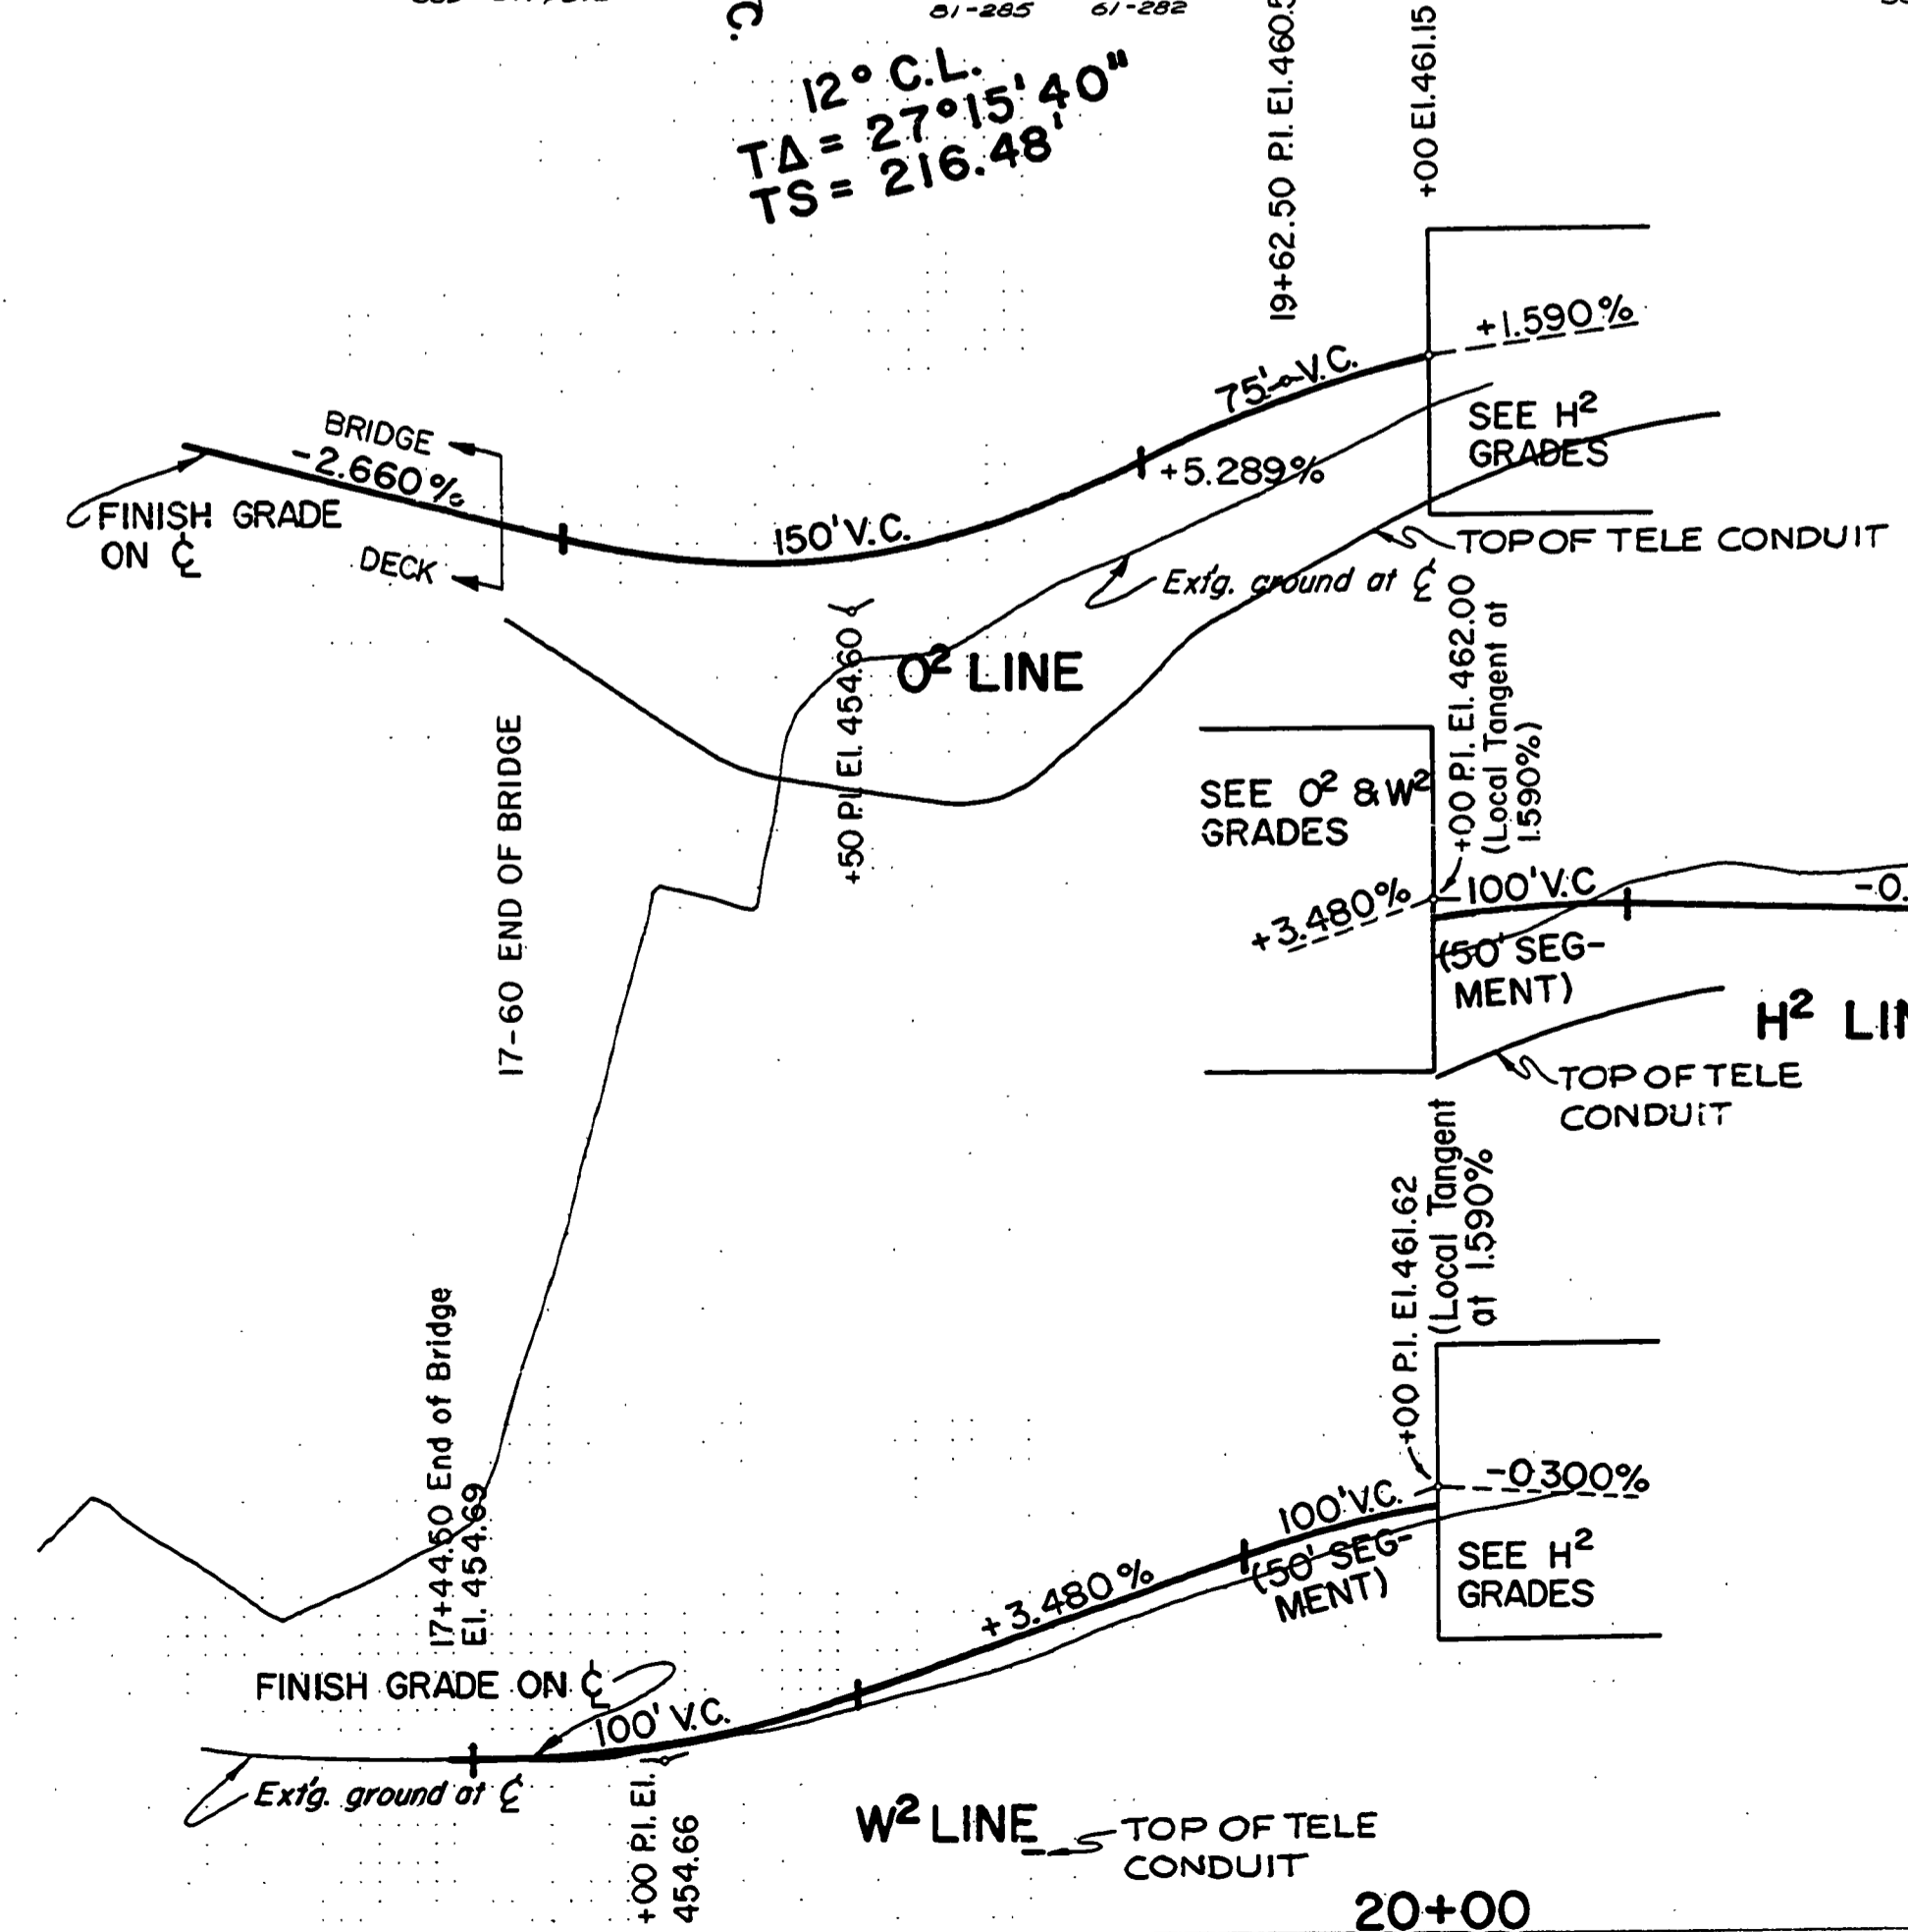
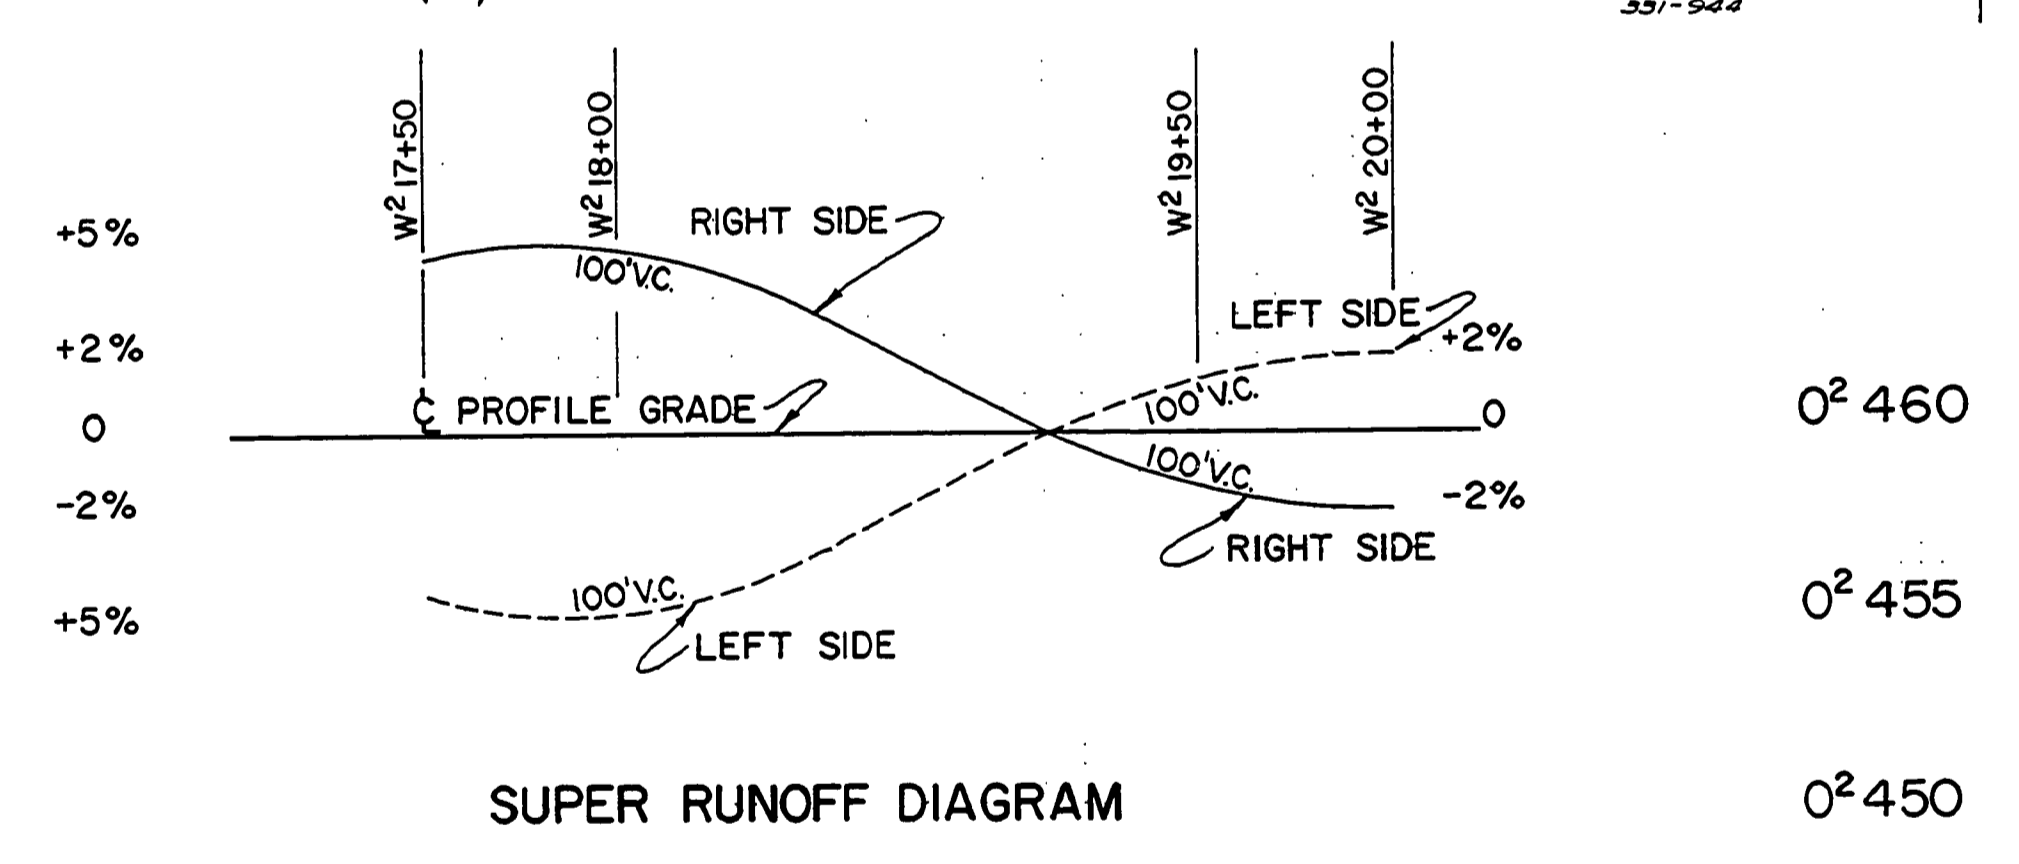


DATE: _____
 BY: _____
 CHECKED: _____
 SUPERVISOR: _____
 NO. _____

DATE: _____
 BY: _____
 CHECKED: _____
 SUPERVISOR: _____
 NO. _____

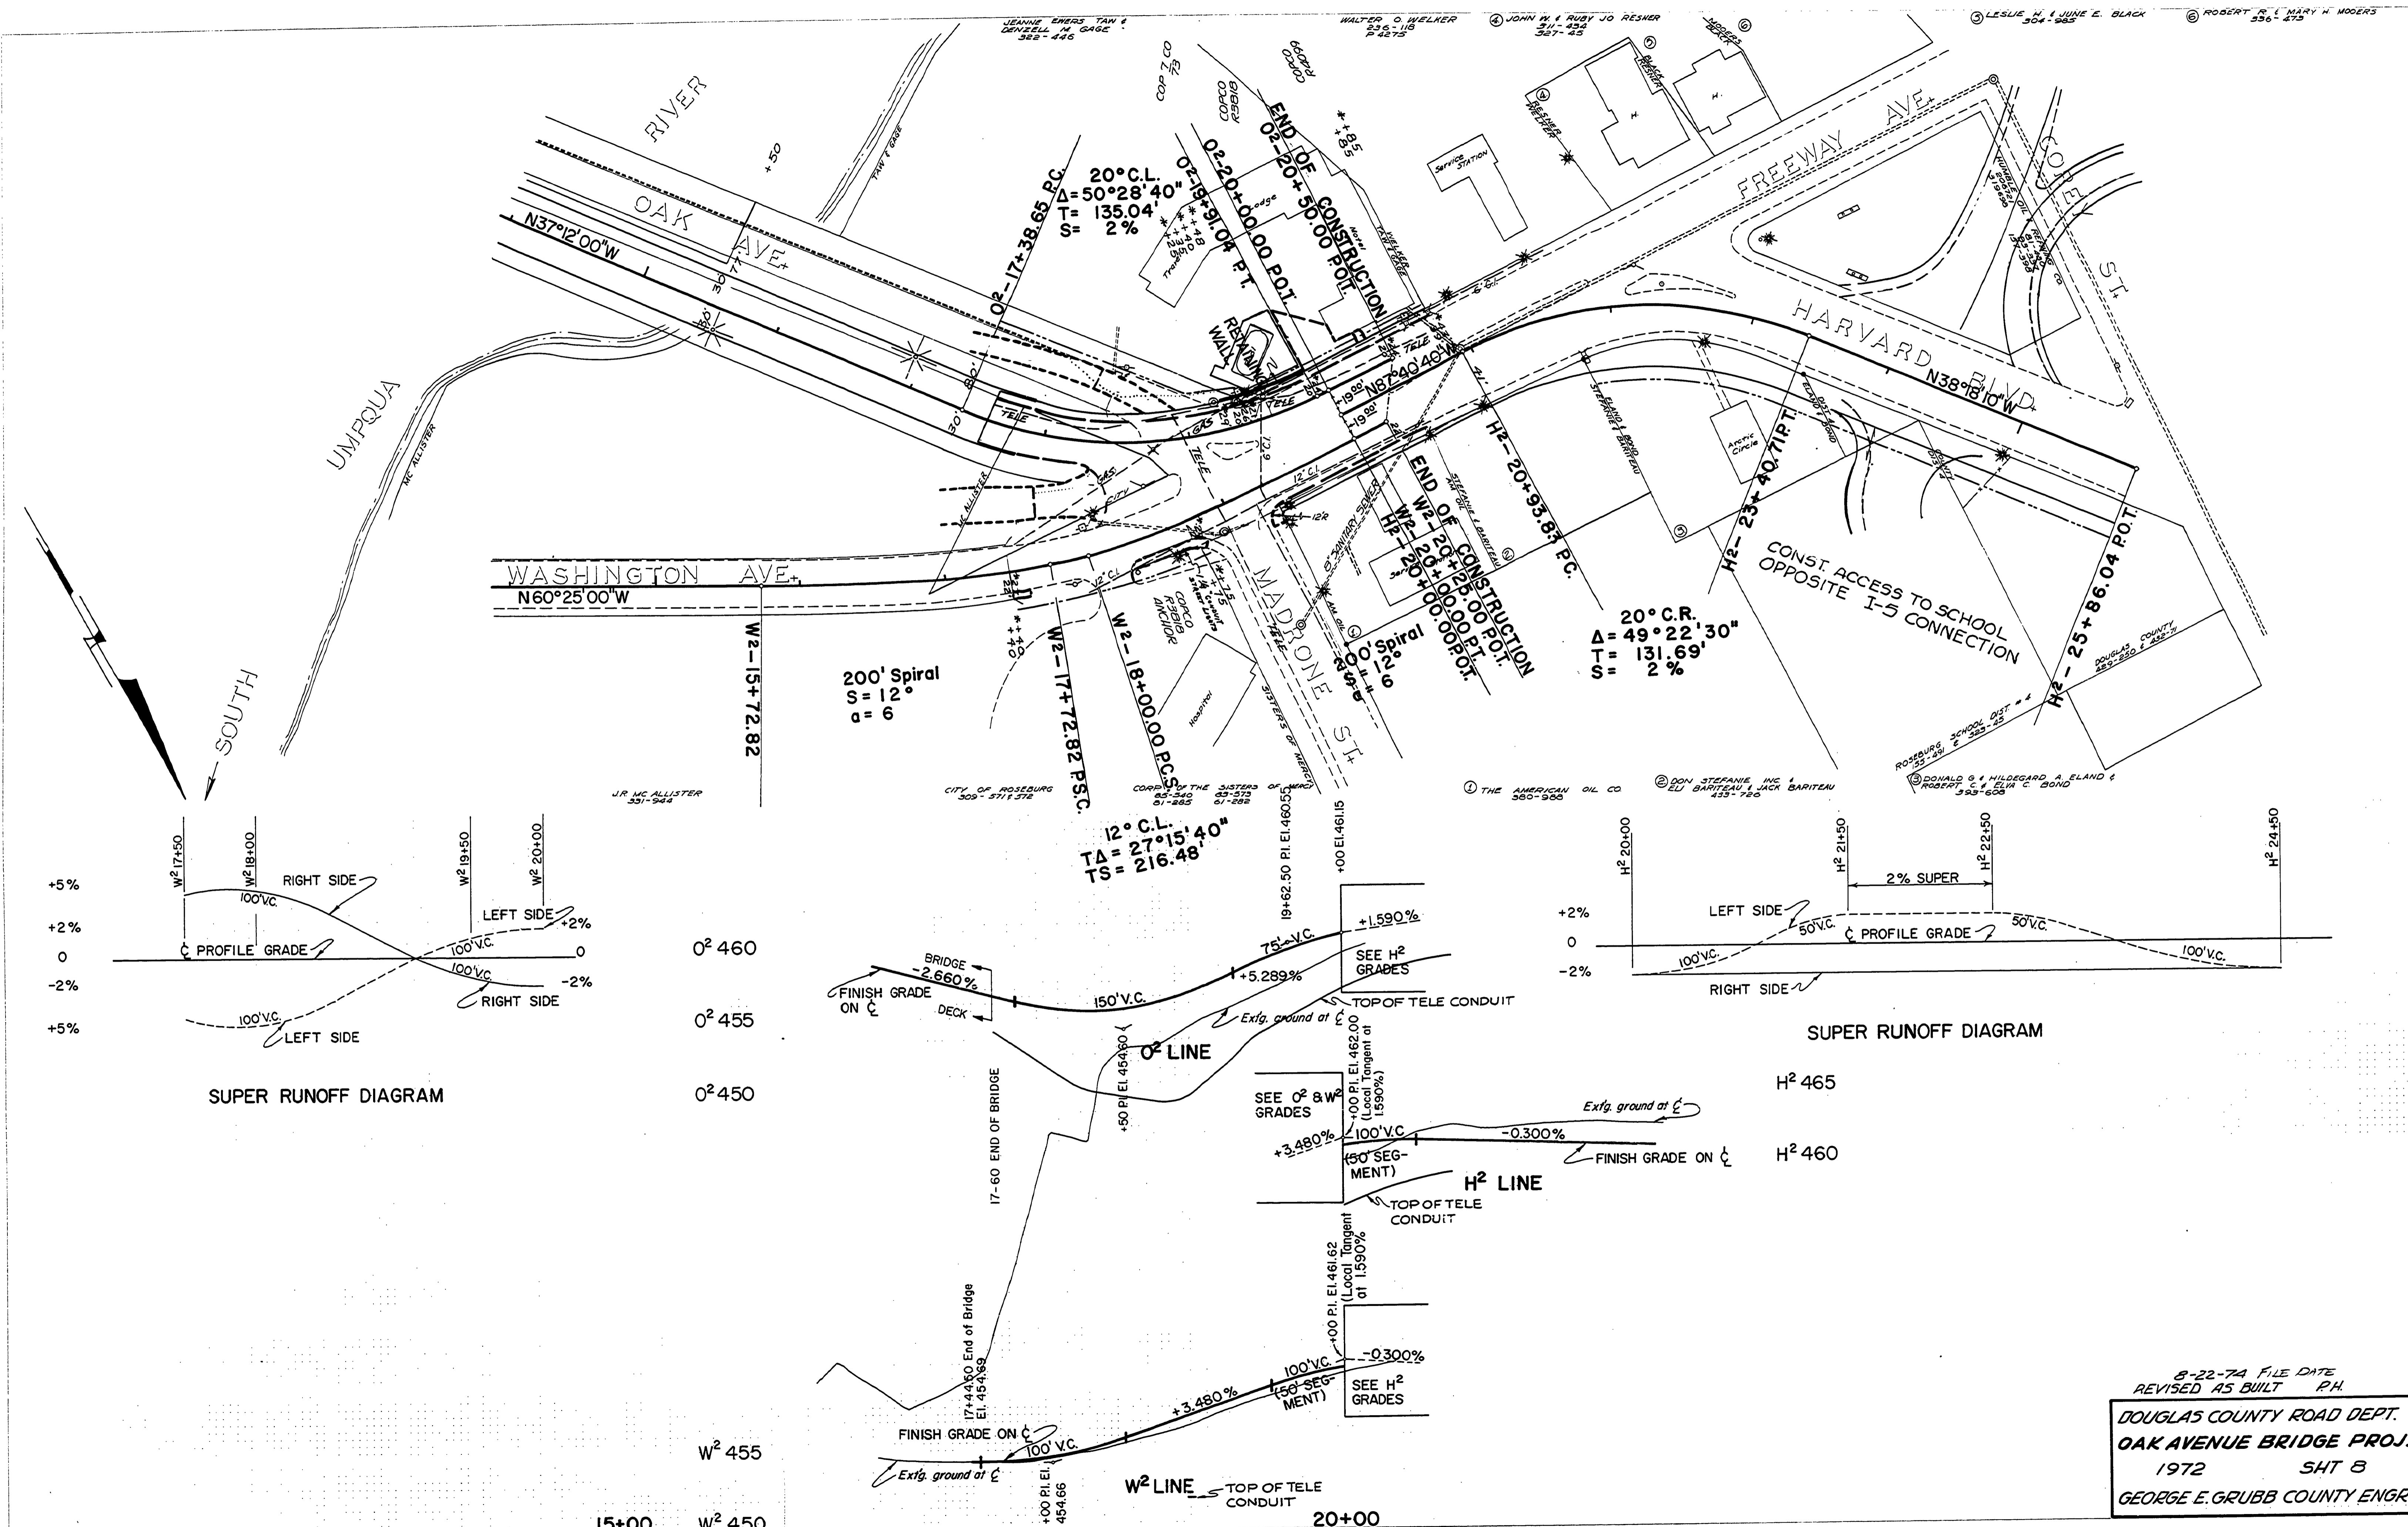

SUPER RUNOFF DIAGRAM

H2 465

H2 460

8-22-74 FILE DATE
 REVISED AS BUILT P.H.
DOUGLAS COUNTY ROAD DEPT.
OAK AVENUE BRIDGE PROJ.
 1972 SHT 8
GEORGE E. GRUBB COUNTY ENGR.