

DOUGLAS COUNTY, OREGON


PLANS FOR PROPOSED PROJECT

GRADING & SURFACING

HARVARD AVENUE & LOOKINGGLASS ROAD

FAIRHAVEN STREET TO GOEDECK ROAD


1973

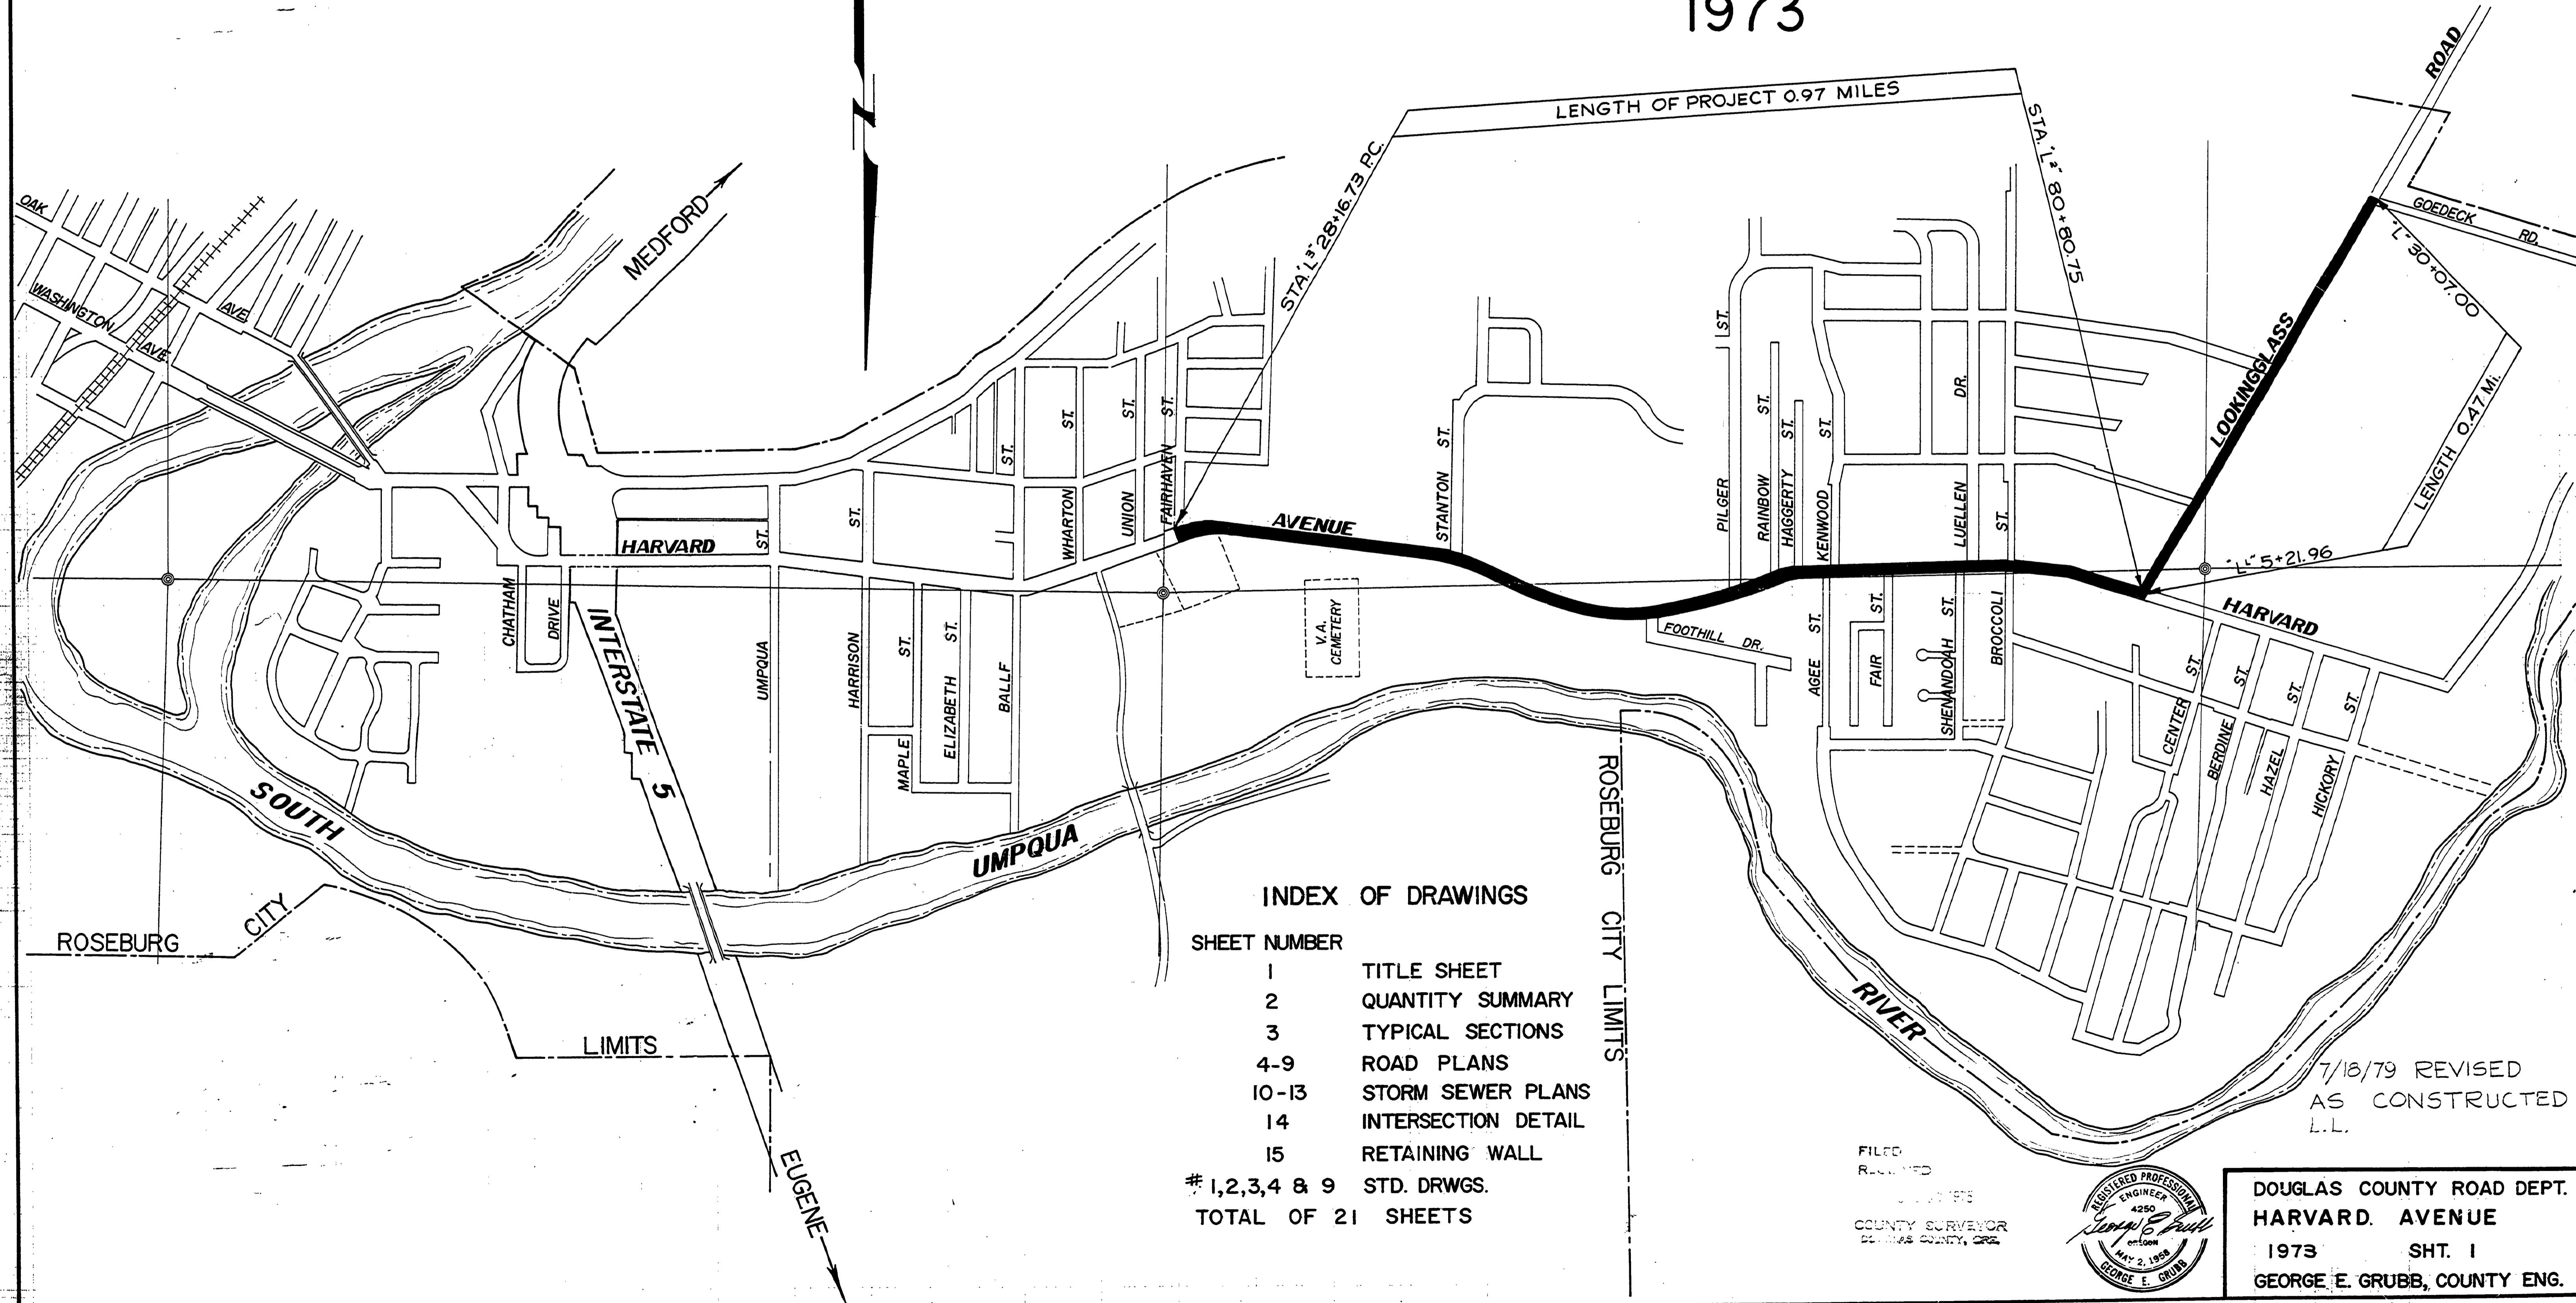

INDEX OF DRAWINGS

SHEET NUMBER	TITLE
1	TITLE SHEET
2	QUANTITY SUMMARY
3	TYPICAL SECTIONS
4-9	ROAD PLANS
10-13	STORM SEWER PLANS
14	INTERSECTION DETAIL
15	RETAINING WALL
# 1,2,3,4 & 9	STD. DRWGS.
TOTAL OF 21 SHEETS	

FILED
RECORDED
MAY 2 1973
COUNTY SURVEYOR
DOUGLAS COUNTY, ORE.

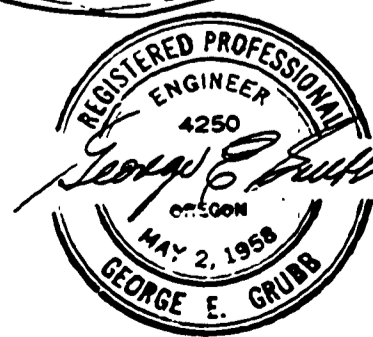

7/16/79 REVISED
AS CONSTRUCTED
L.L.

DOUGLAS COUNTY ROAD DEPT.
HARVARD AVENUE
1973 SHT. 1
GEORGE E. GRUBB, COUNTY ENG.