


SECS. 23, 14 T 27S R 6W W.M.


PLAN	SEARCHED	INDEXED
	FILED	FILED
	NOTED	NOTED
	RECORDED	RECORDED
	BY	BY
	DATE	DATE

PROFILE	GRADED	DATE
	NOTED	
	NOTED	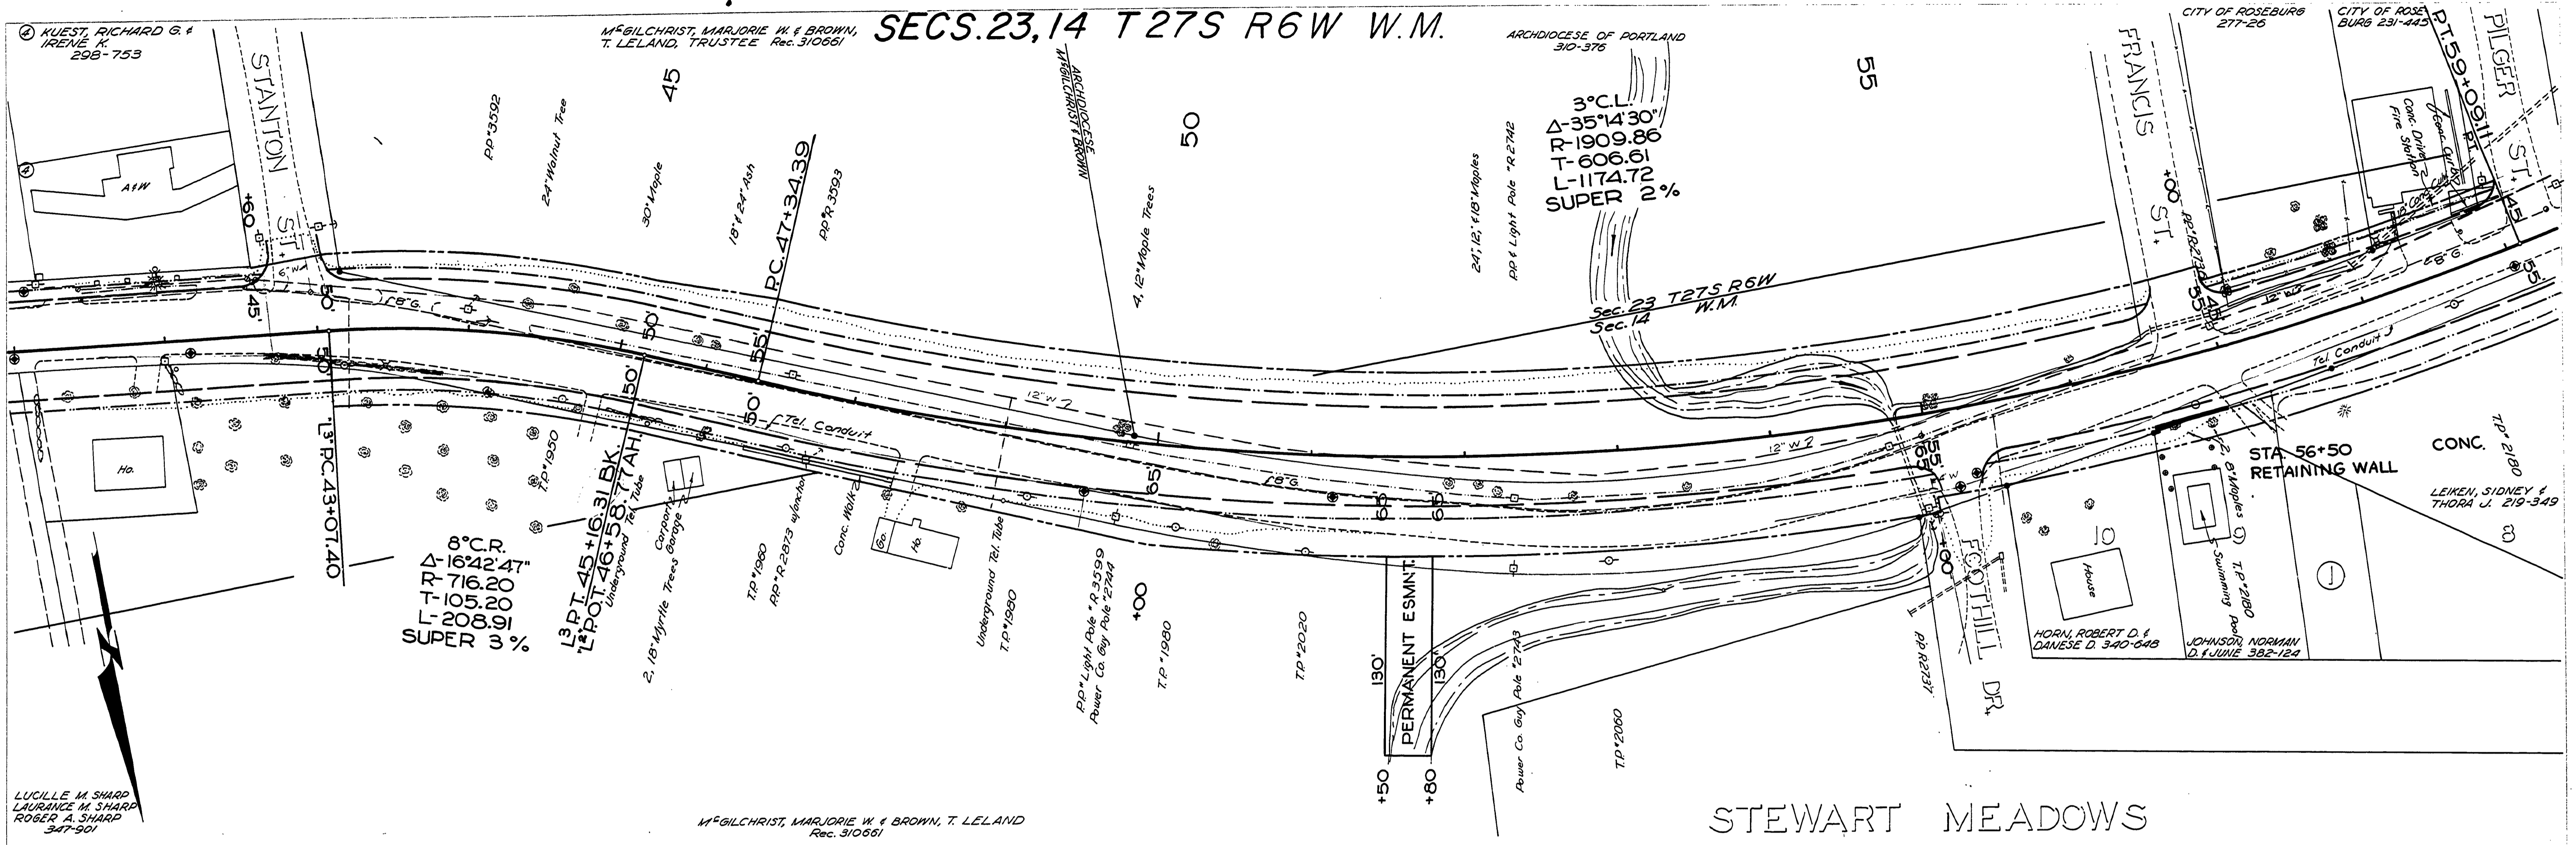
LUCILLE M. SHARP
LAURANCE M. SHARP
ROGER A. SHARP
347-901

M^{rs} GILCHRIST, MARJORIE W. & BROWN, T. LELAND
Rec. 310661

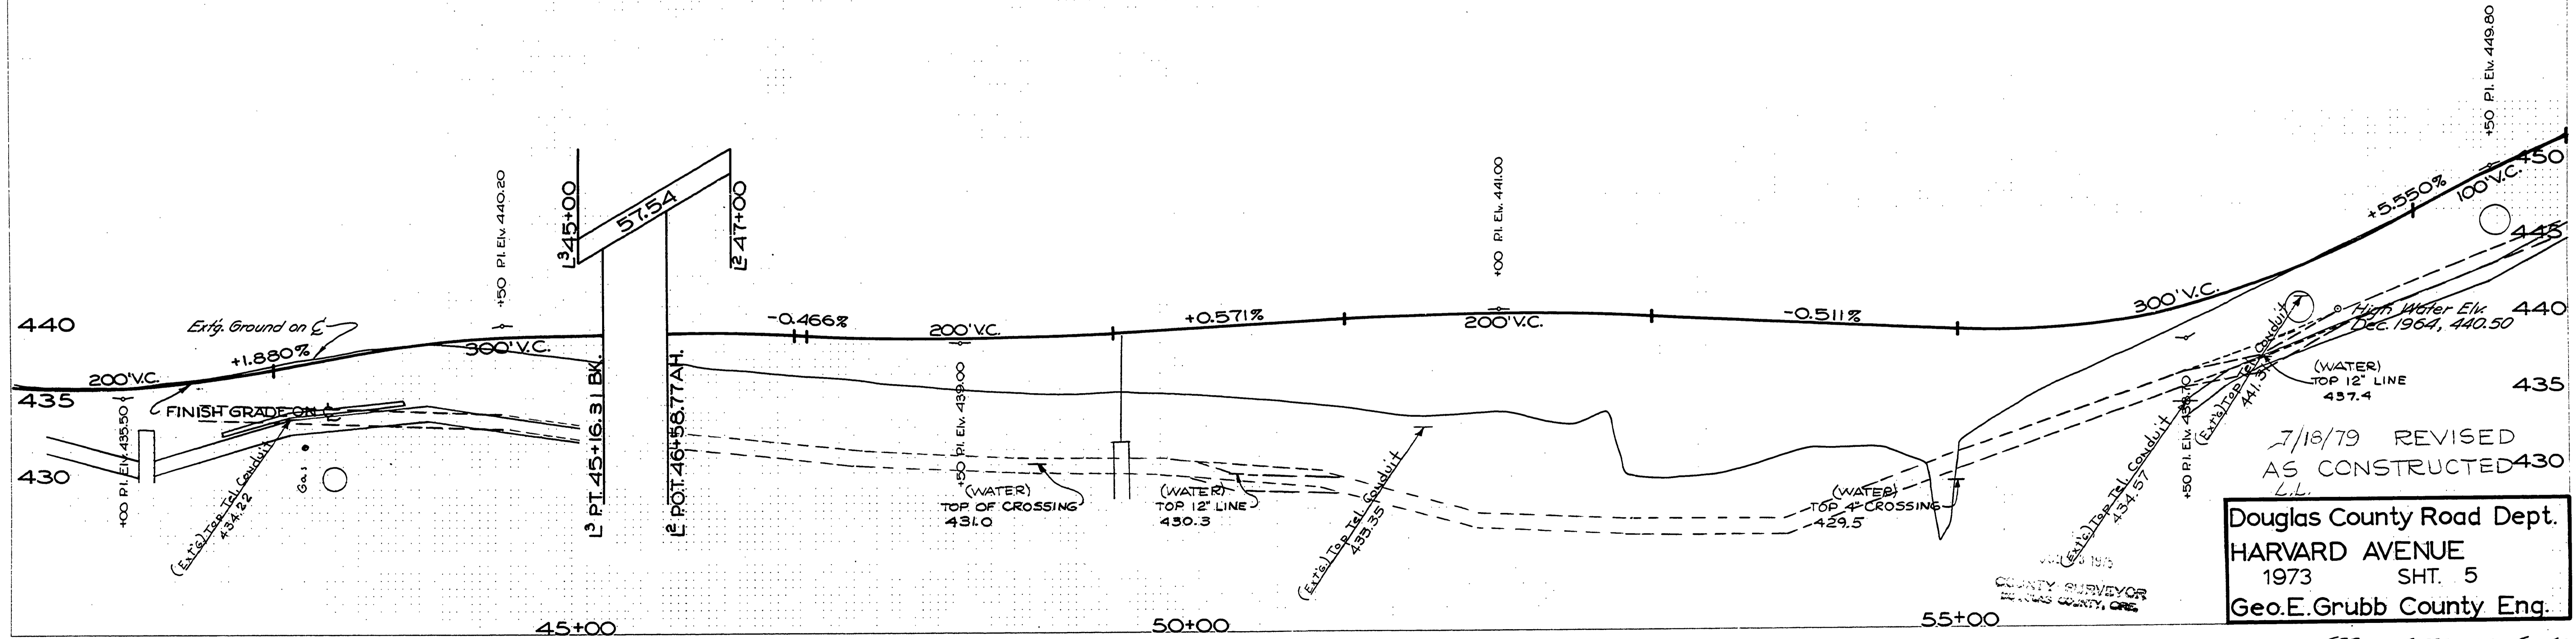

7/18/79 REVISED
AS CONSTRUCTED
L.L.

Douglas County Road Dept.
HARVARD AVENUE
1973 SH. 5
Geo. E. Grubb County Eng.