

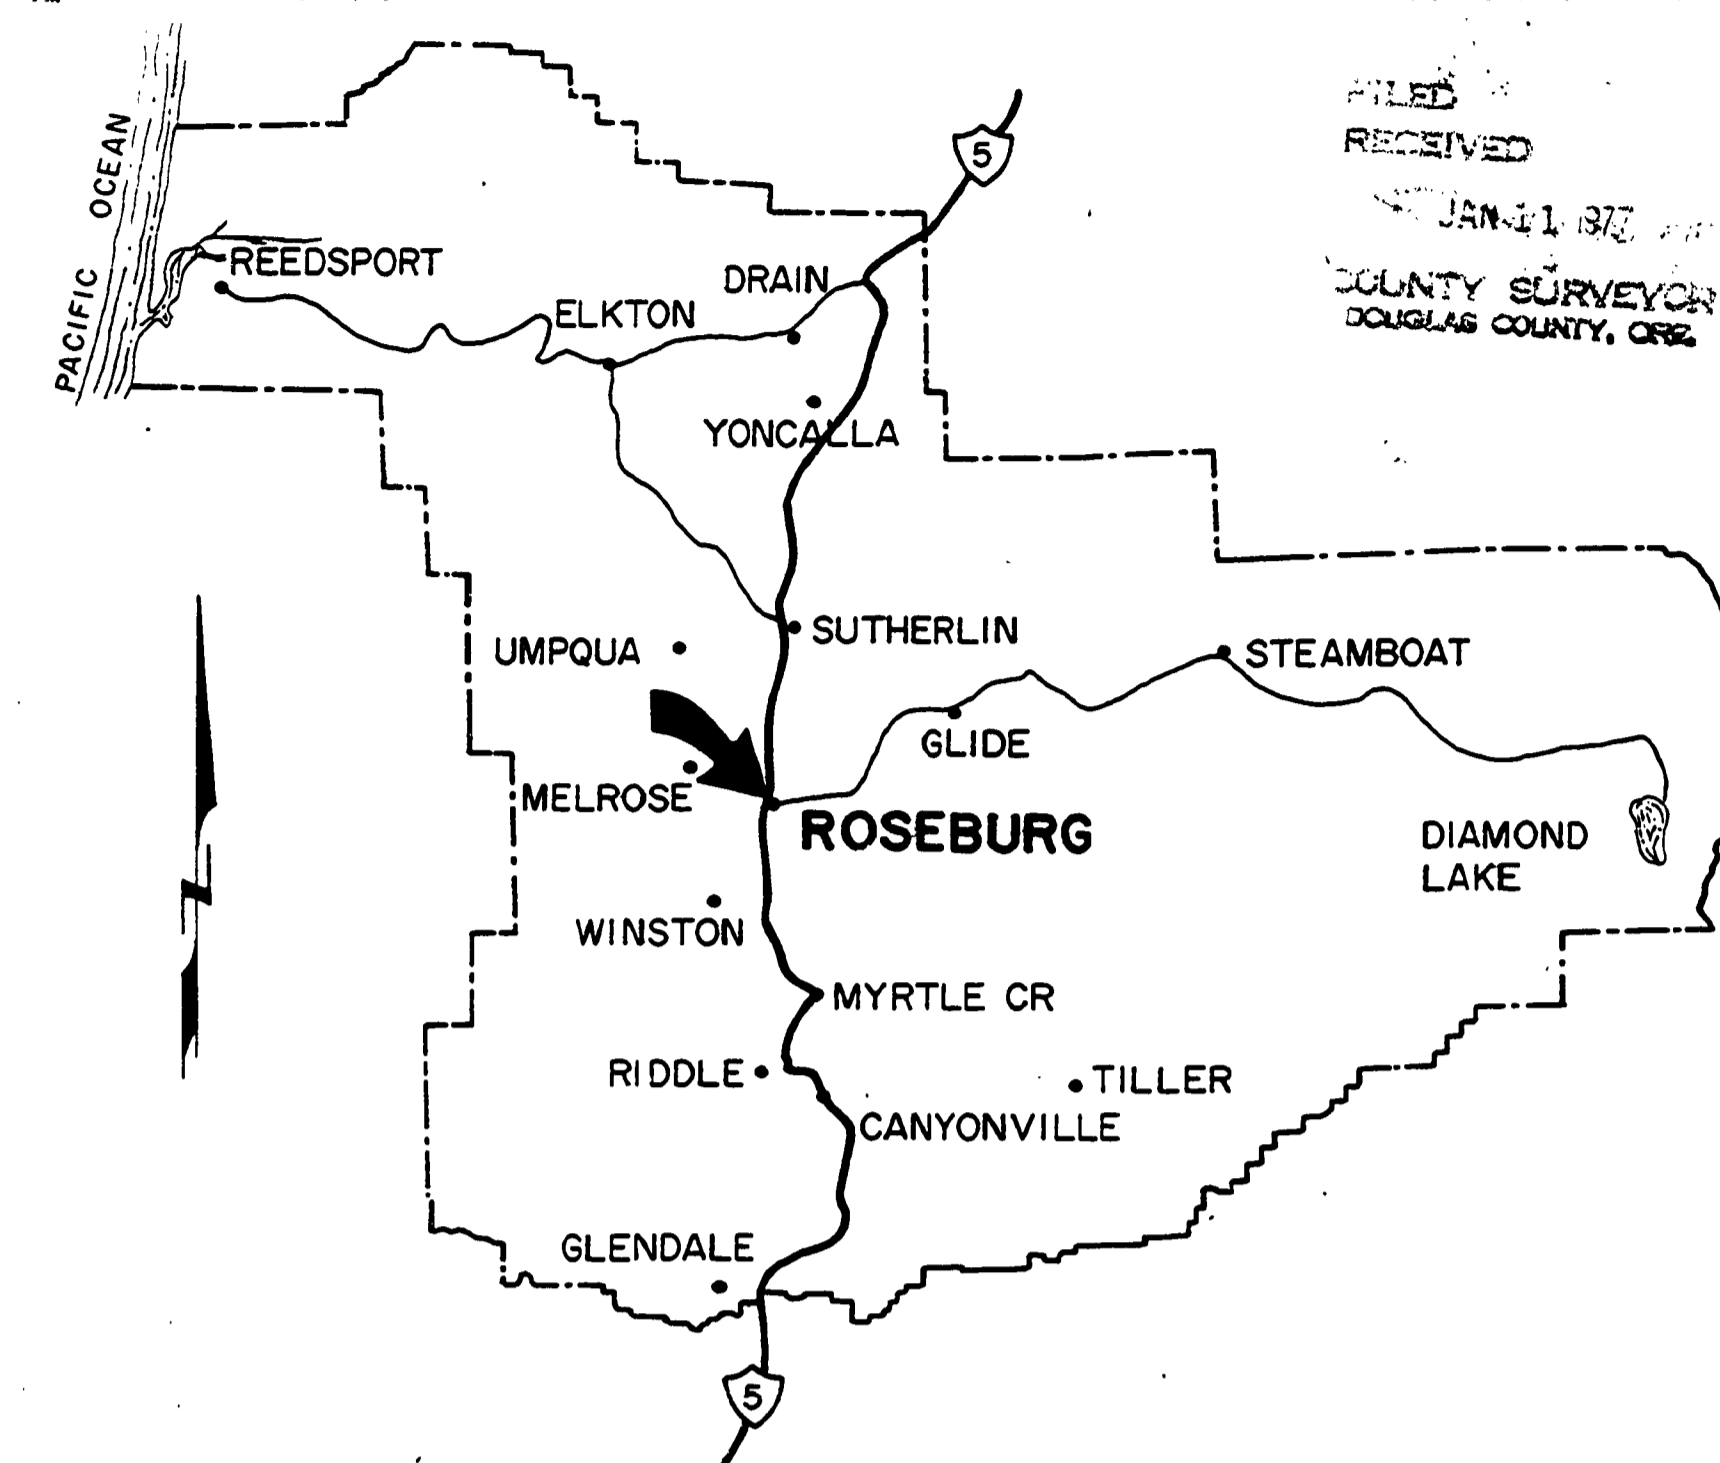


DOUGLAS COUNTY, OREGON  
 PLANS FOR PROPOSED PROJECT  
 GRADING, SURFACING, STORM  
 SEWER, & SANITARY SEWER

**GARDEN HOMES SUBDIVISION**  
**1976**

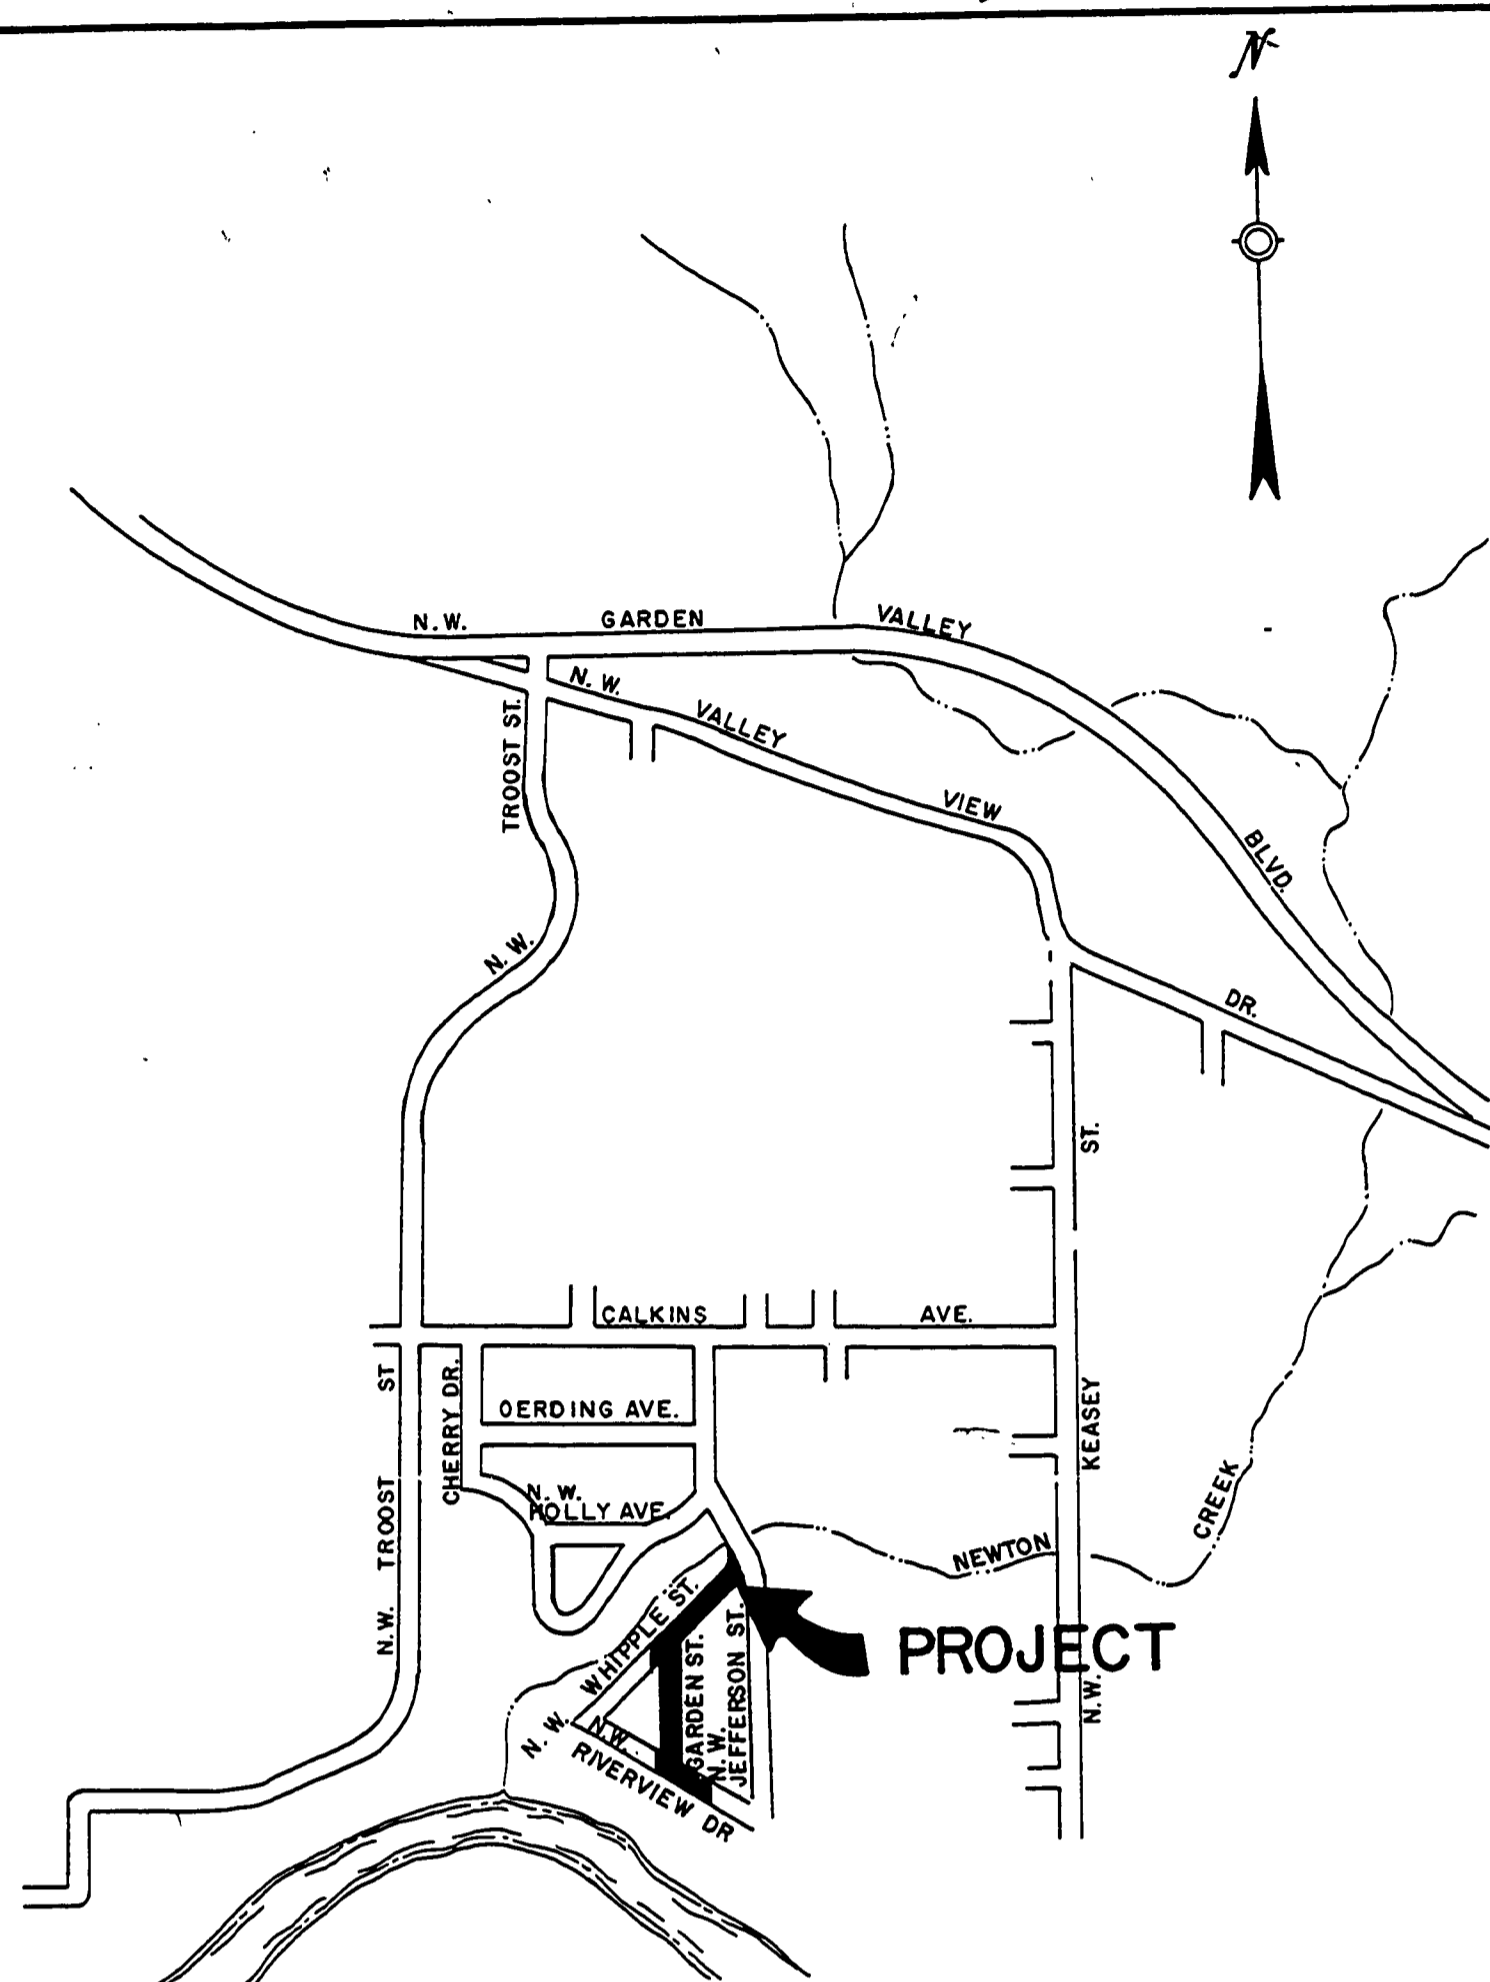


**ROSEBURG**

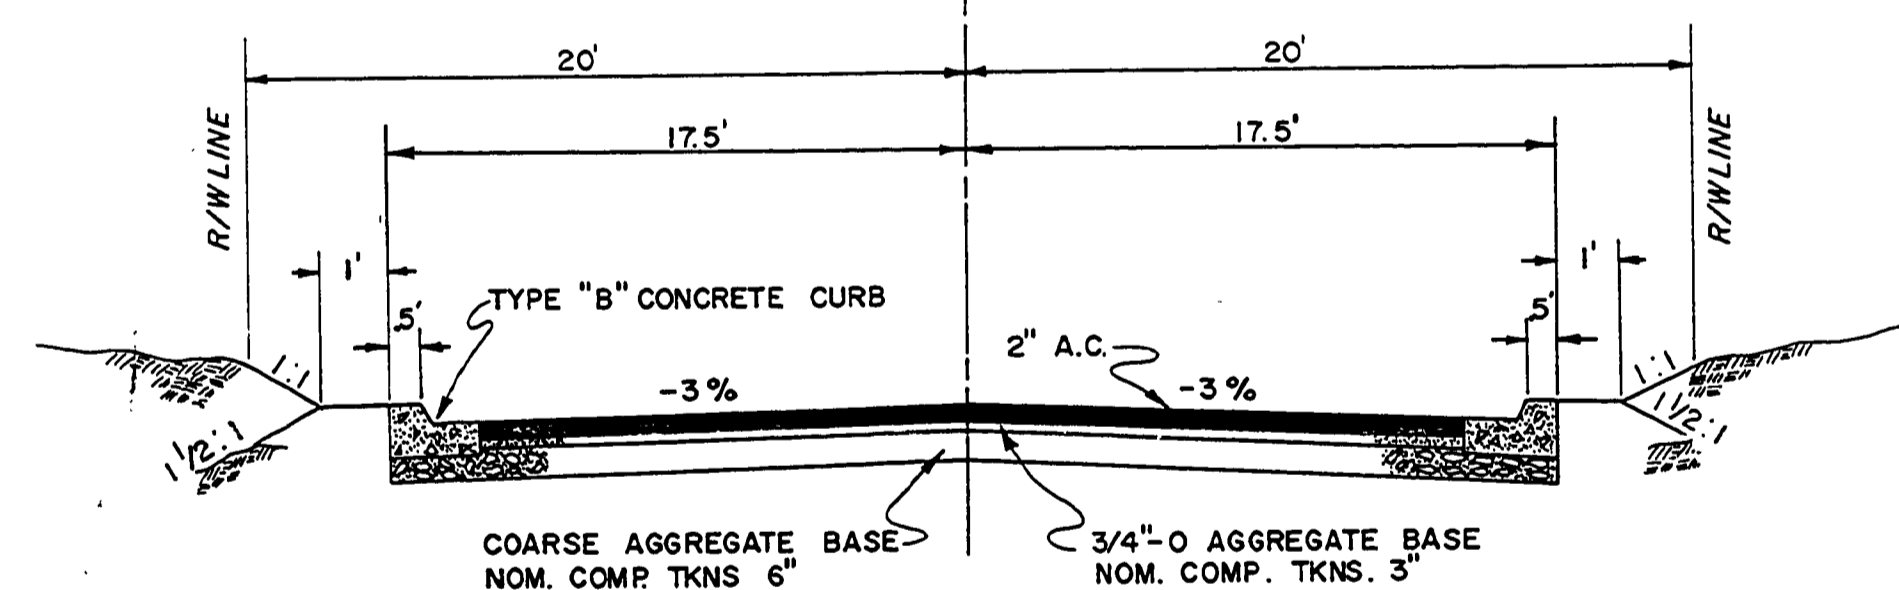


**TYPICAL SECTION**

WHIPPLE AVE STA. 0+82 TO 5+50  
 GARDEN ST. STA. 10+00 TO 15+85.17

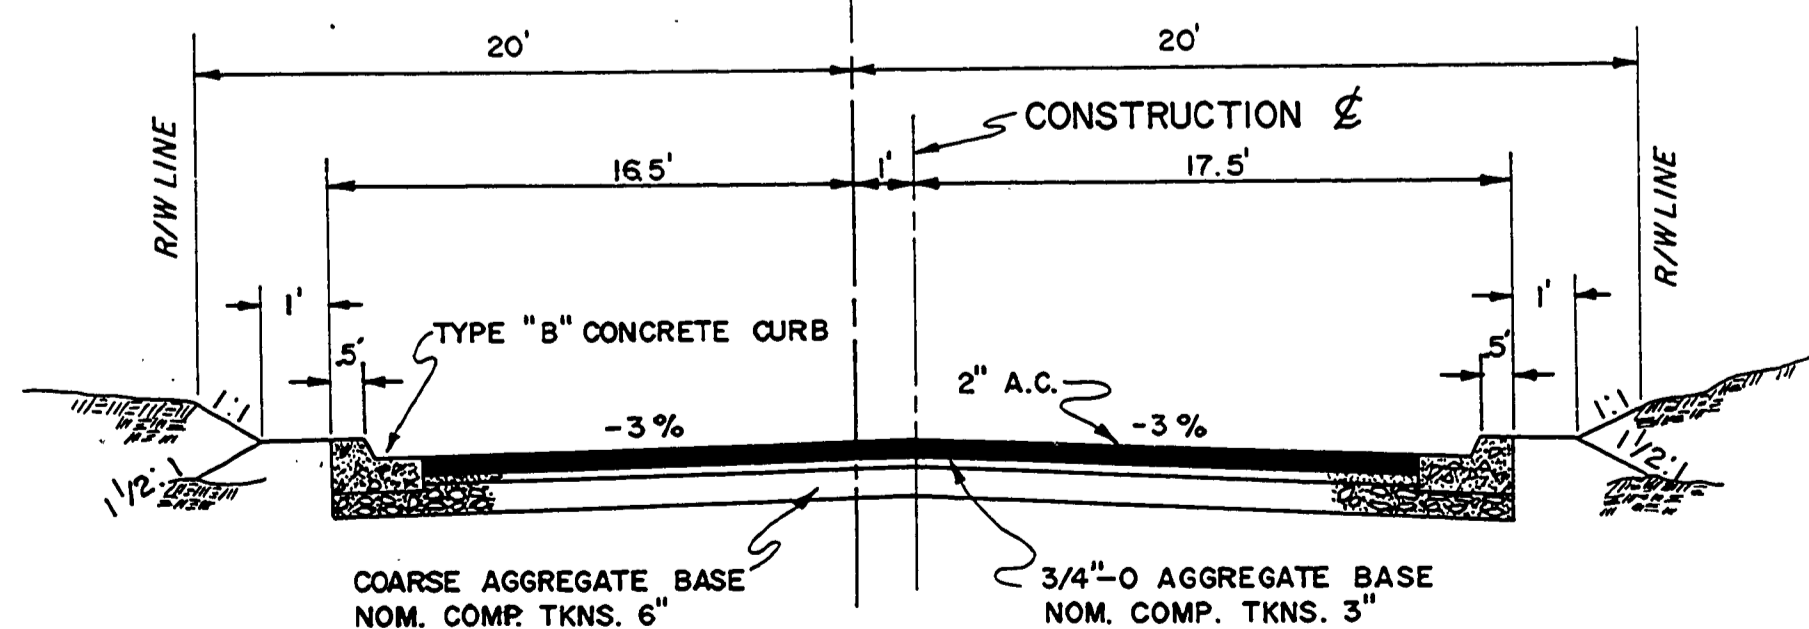

**TYPICAL SECTION**

RIVERVIEW DR. STA. 21+08 TO 23+70

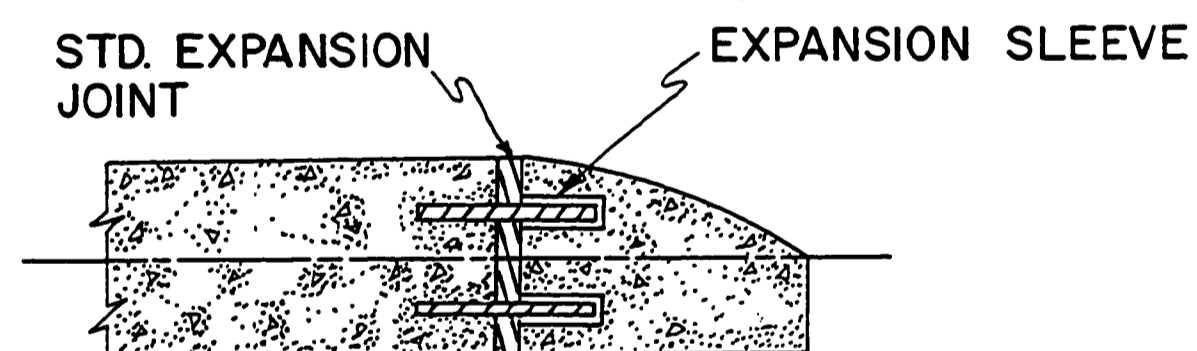

TYPICAL SECTION FOR  
 CURB ENDS AT STA. W 5+00 RT.  
 W 5+41 LT.  
 R 23+65 LT.  
 R 23+75 RT.

**INDEX OF DRAWINGS**

- SHEET No.
- 1 COVER SHEET
  - 2 QUANTITY SUMMARY
  - 3 ROAD PLANS
  - 4 STORM SEWER
- STANDARD DRAWING  
 1, 2, 4 & 9  
 5 & 6 SANITARY SEWER PLANS

10 SHEETS TOTAL



AS CONSTRUCTED  
 B.B.B. 1-11-77

SURVEYED	_____	DOUGLAS COUNTY PUBLIC WORKS DEPARTMENT <b>GARDEN HOMES SUBDIV.</b> 1976 SHT. 1 GEORGE E. GRUBB, DIRECTOR
DESIGNED	_____	
DRAFTED	_____	
REVIEWED	_____	
BOOK	_____	