


290-8161 602S

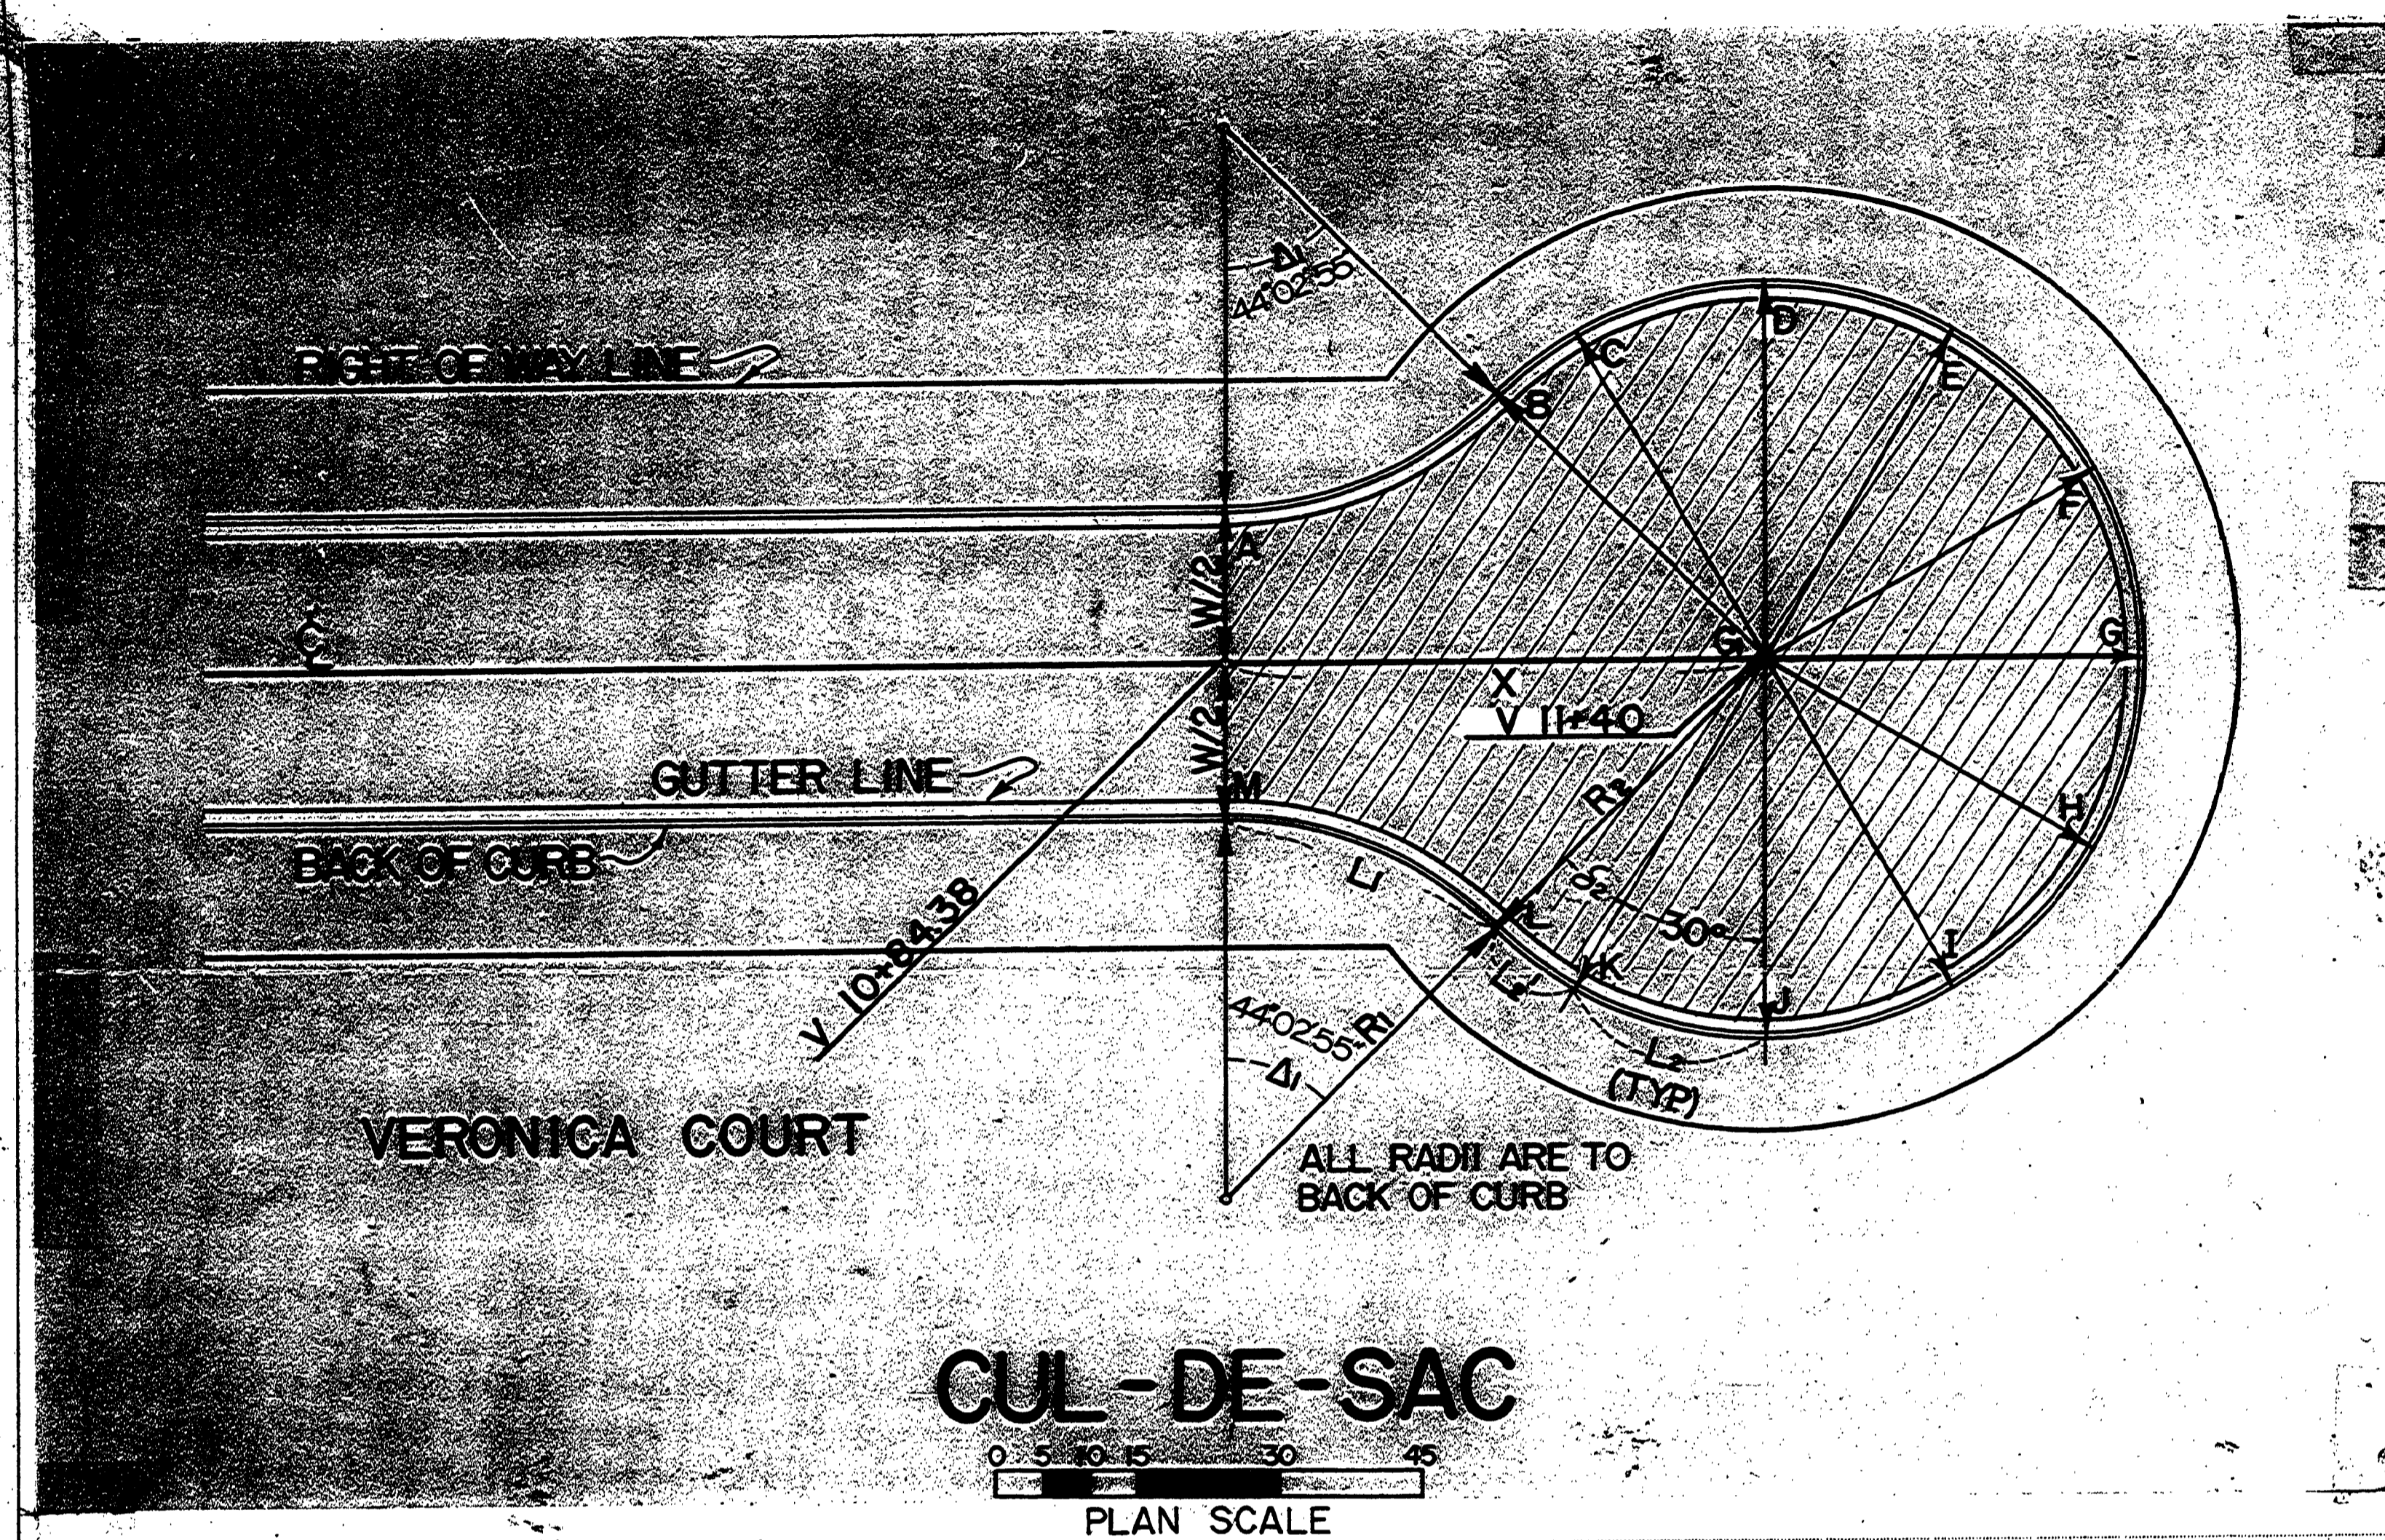


W	R <sub>1</sub>	Δ <sub>1</sub>	L <sub>1</sub>	R <sub>2</sub>	Δ <sub>2</sub>	L <sub>2</sub>	Δ <sub>3</sub>	L <sub>3</sub>	X	AREA
35	40	44°02'55"	30.75	40	268°05'50"	20.94	14°02'55"	9.81	55.62	5.220

AREA FIGURES ARE FOR SHADED PORTION OF CUL-DE-SAC. (Ft.<sup>2</sup>)


A	B	C	D	E	F	G	H	I	J	K	L	M	G <sub>1</sub>	G <sub>2</sub>
488.57	492.01	493.11	495.41	497.31	497.99	497.36	495.47	493.46	491.57	489.91	489.19	486.86		

G<sub>2</sub> EXISTS ONLY IN THE CASE OF A V.C. W/G<sub>1</sub> AS THE P.I.

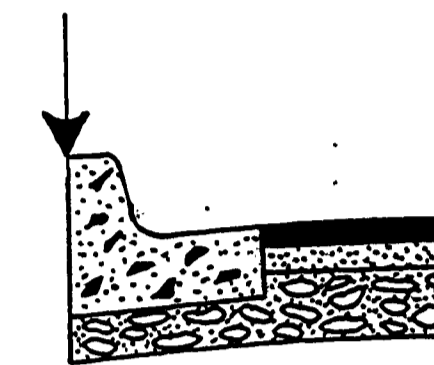

TYPE B CURB & GUTTER  
ELEVATIONS LISTED CORRESPOND TO LOCATIONS SHOWN

FILED  
RECEIVED  
JUN 27 1978  
COUNTY SURVEYOR  
DOUGLAS COUNTY, ORE.

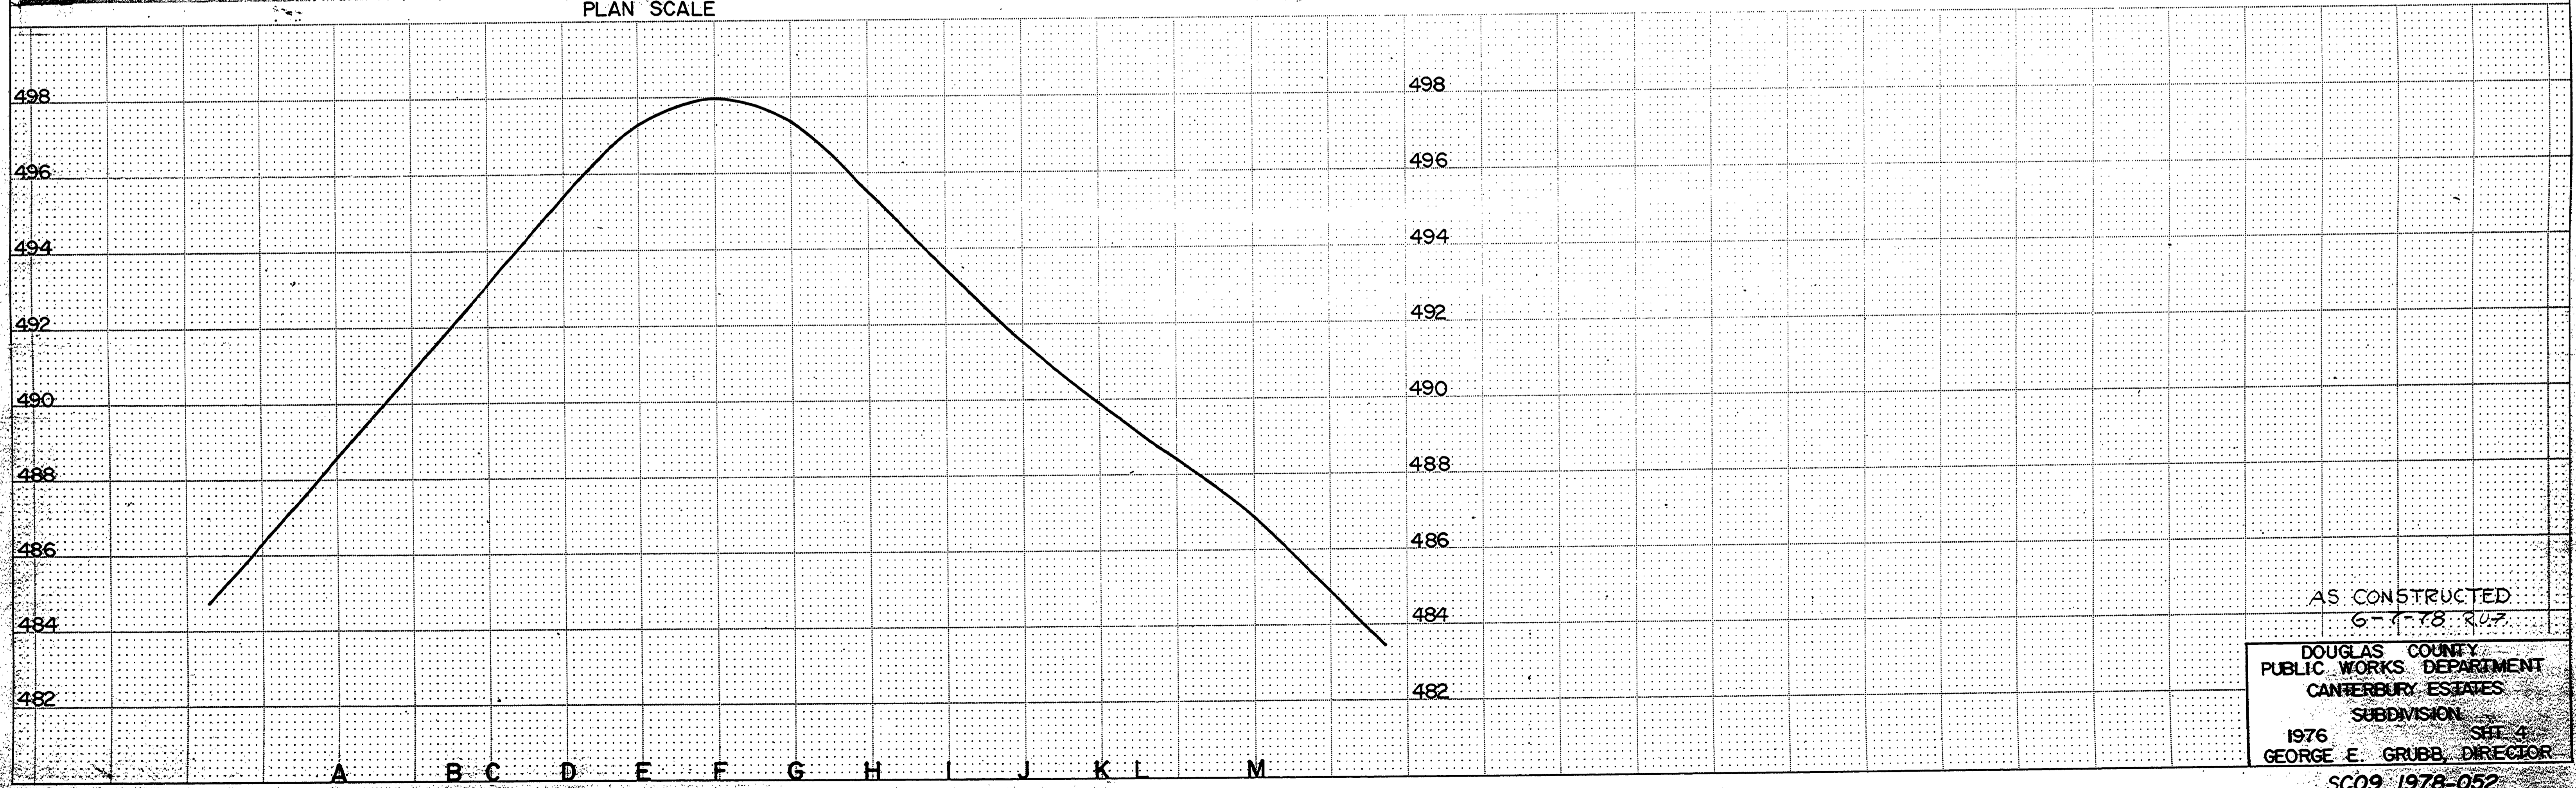

AS CONSTRUCTED  
6-7-78 R.U.F.  
DOUGLAS COUNTY  
PUBLIC WORKS DEPARTMENT  
CANTERBURY ESTATES  
SUBDIVISION  
1976 SHEET 4  
GEORGE E. GRUBB, DIRECTOR  
SC09 1978-052