


SEC 3 & 4 T23S R5W W.M.

|         |           |      |
|---------|-----------|------|
| PLAN    | REVISIONS | DATE |
| NO. 1   | AS SHOWN  |      |
| NO. 2   | AS SHOWN  |      |
| NO. 3   | AS SHOWN  |      |
| NO. 4   | AS SHOWN  |      |
| NO. 5   | AS SHOWN  |      |
| NO. 6   | AS SHOWN  |      |
| NO. 7   | AS SHOWN  |      |
| NO. 8   | AS SHOWN  |      |
| NO. 9   | AS SHOWN  |      |
| NO. 10  | AS SHOWN  |      |
| NO. 11  | AS SHOWN  |      |
| NO. 12  | AS SHOWN  |      |
| NO. 99  | AS SHOWN  |      |
| NO. 100 | AS SHOWN  |      |

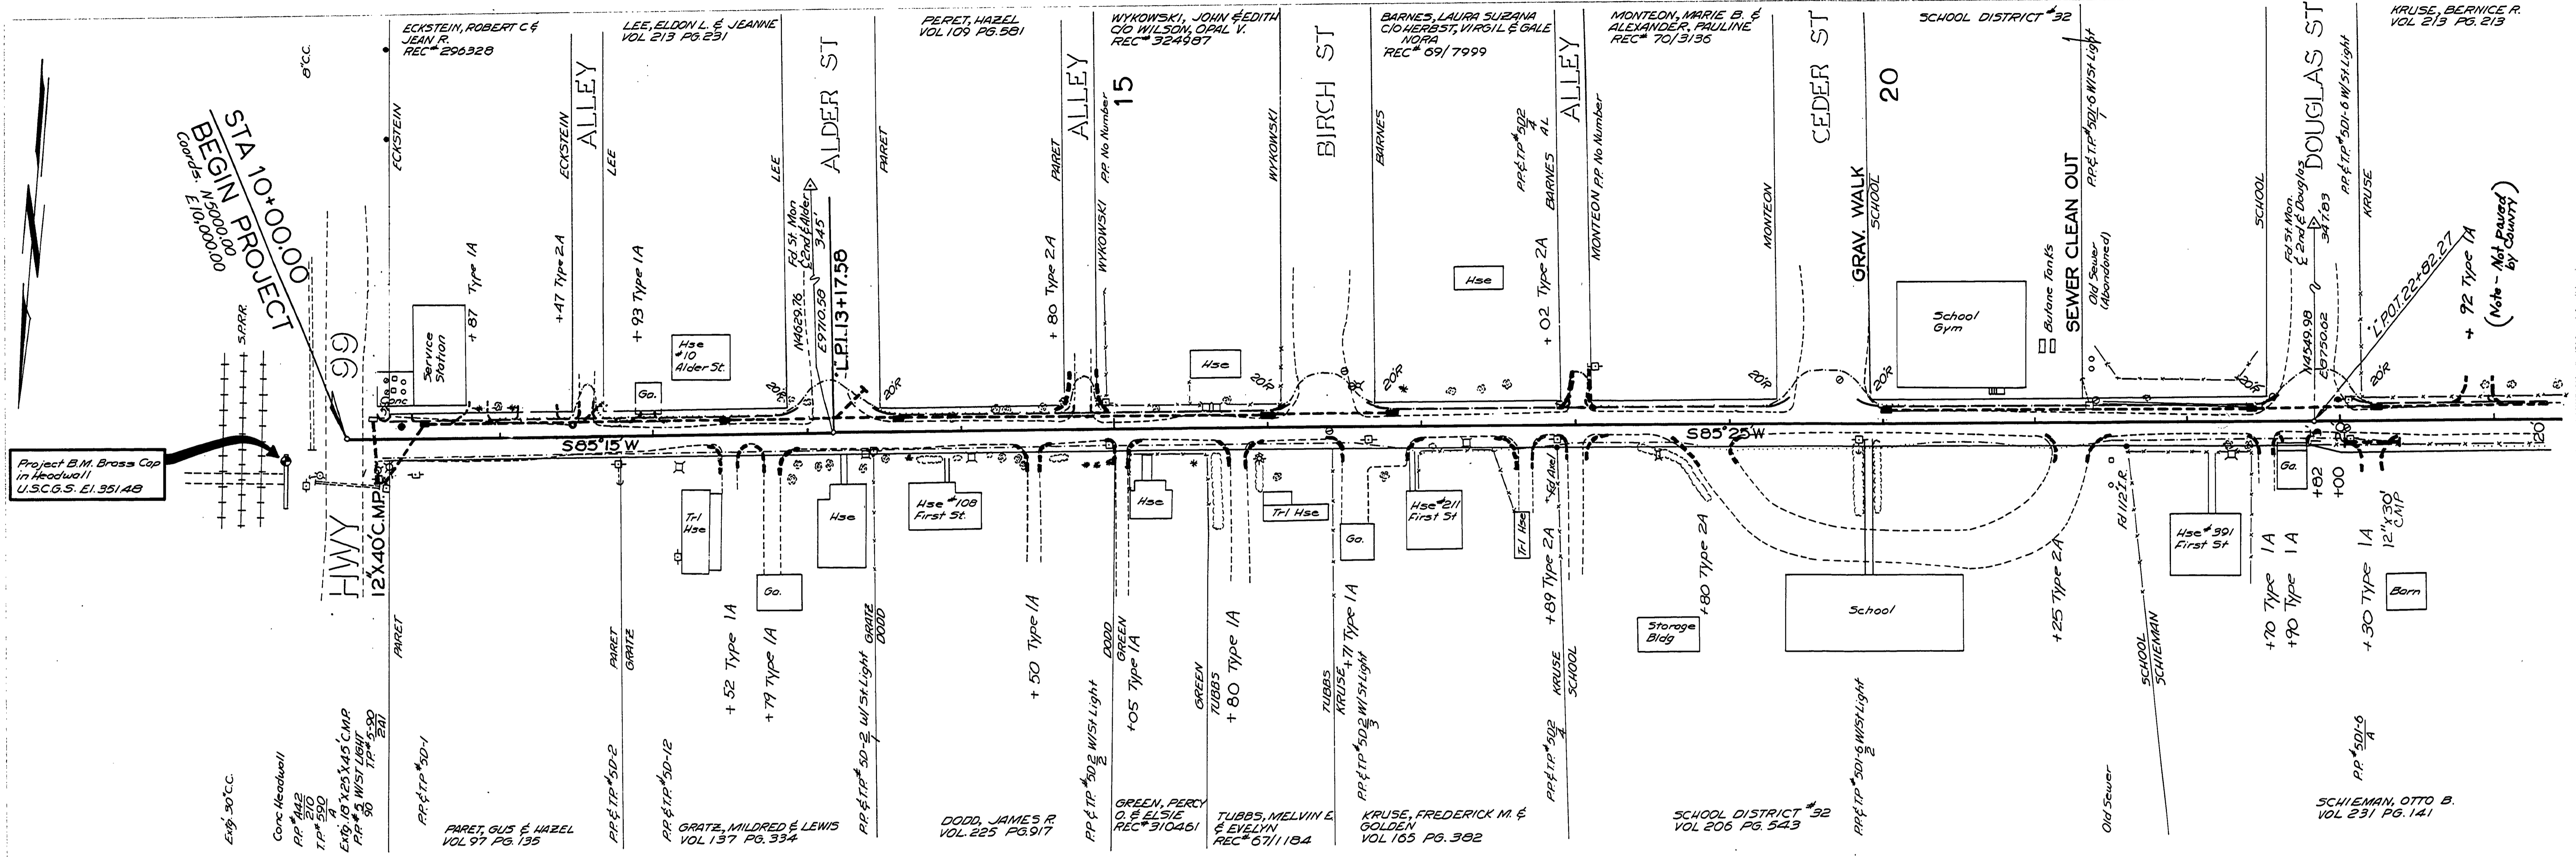


Project B.M. Brass Cap in Headwall  
U.S.C.G.S. E1.35148

STA 10+00.00  
BEGIN PROJECT

HWY 12X40C.M.P.

380  
375  
370  
365  
360  
355  
350

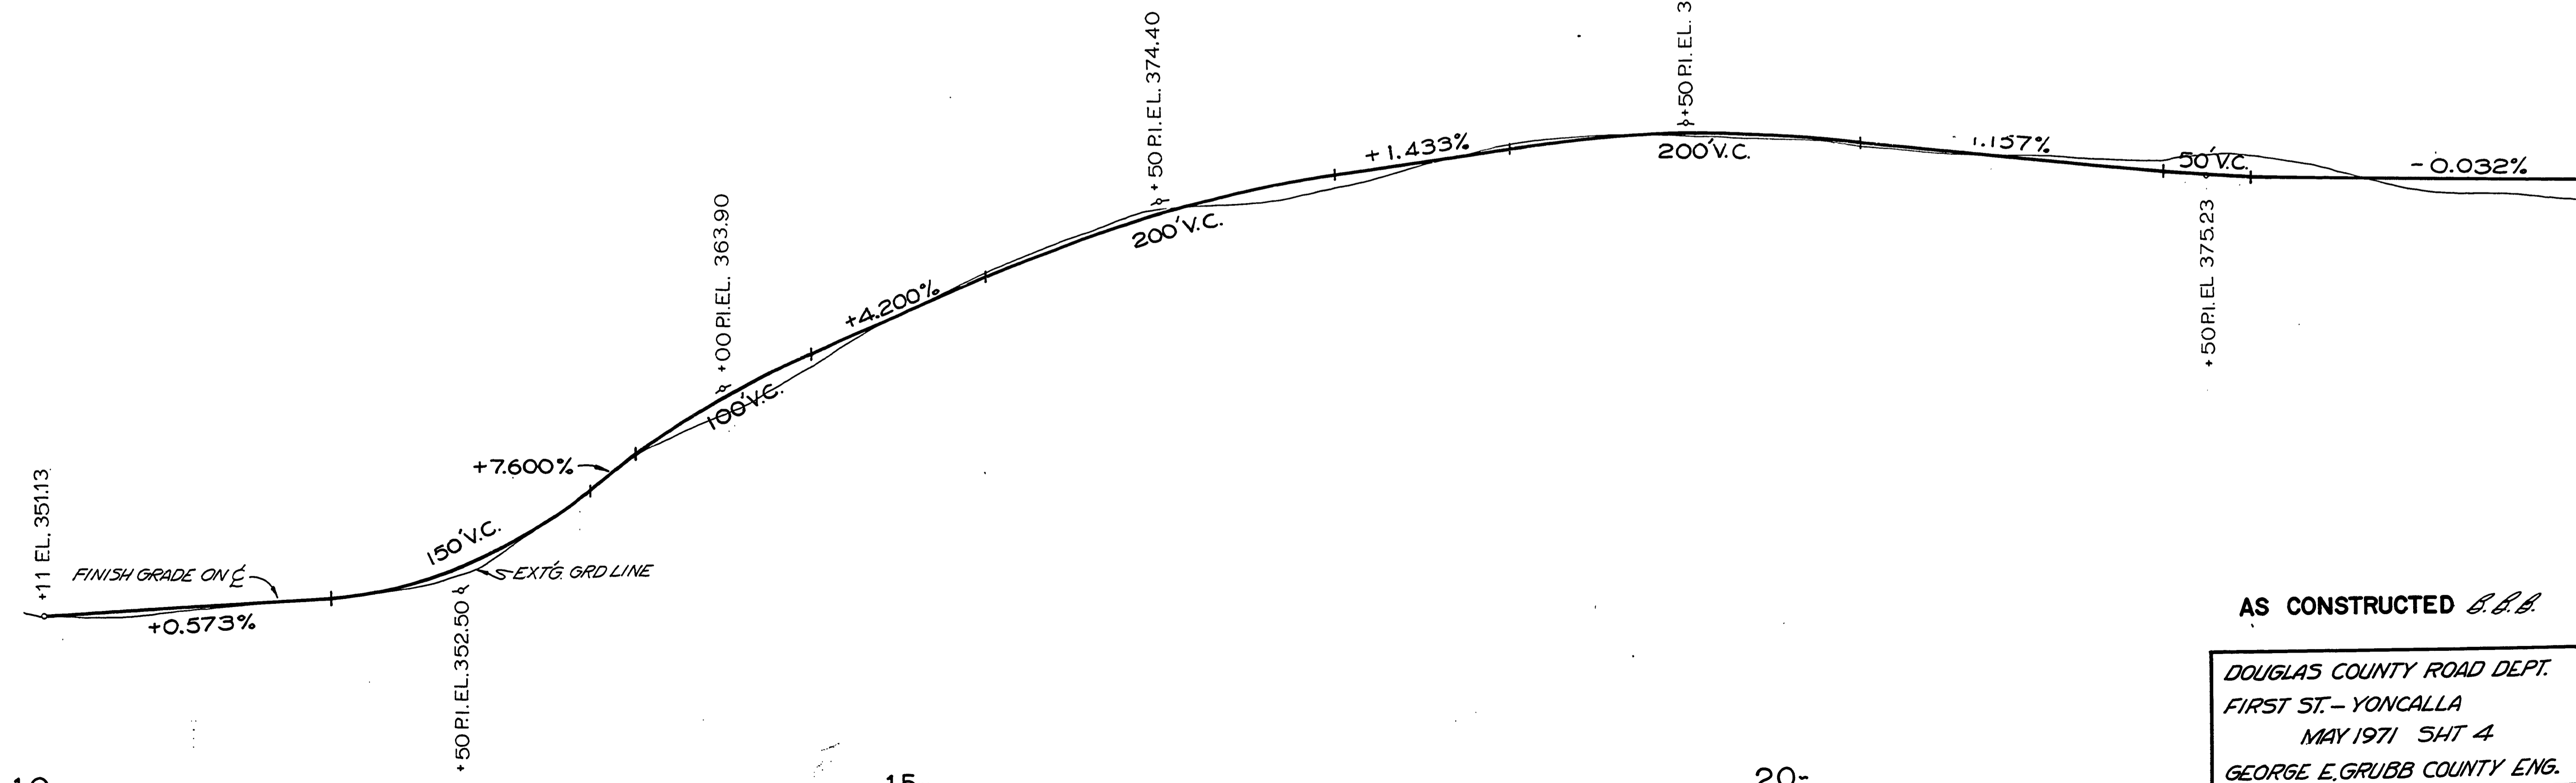

AS CONSTRUCTED *B.B.B.*  
DOUGLAS COUNTY ROAD DEPT.  
FIRST ST.-YONCALLA  
MAY 1971 SHT 4  
GEORGE E. GRUBB COUNTY ENG.

10-

15-

20-