

1/30/01

7-003


OFFICE OF THE

~~7-003~~  
7-29

223 SW 17

DOUGLAS COUNTY SURVEYOR

NAD 738185.69 4176287.27  
83 43°39'28" 123°18'56"

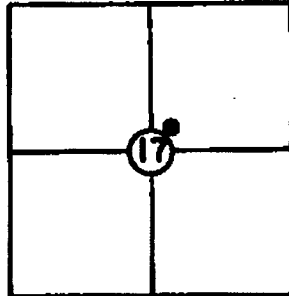

T 22 S, R SW, Sec. 17

Station: 7-29

Set By (Agency): \_\_\_\_\_

Date: \_\_\_\_\_

RECORDED BY: PD OK PER 1495-0017

VERTICAL CONTROL

FD. OK 7/99 DCSO 1/15 DOLAN  
FD OK 8/00 DCSO

Elevation: 297.41 NGS(USC&GS) Line # \_\_\_\_\_ USGS Line # \_\_\_\_\_

Order Of Precision 3rd Agency: DCSO Proj. #: \_\_\_\_\_ Date: 2000

CORPCON 6 NAVD 88  
301.02 FT

HORIZONTAL CONTROL

Oregon State Plane Coordinates: Y(Northing) 738,220.51 X(Easting) 1,255,326.72  
(South Zone)


Order Of Precision 1/15,000 Agency: DCSO Proj. #: 2008 Date: 1979

Approximate Geographic Position: Latitude=<sup>(27)</sup> 43 39 28.7 Longitude=123 18 52.1

DESCRIPTION: Monument is a spike with shiner, stamped "L" (not "7" as noted in record) on the spike and "29" on the shiner. Spike is on the SE end of RR bridge crossing Elk Creek and 1st St. 3 ft. from edge of metal bridge.

Mark difference noted 8/2000 DCSO

VICINITY: .35 mi. Southerly from intersection of 1st St. with Hwy 99 in Drain.

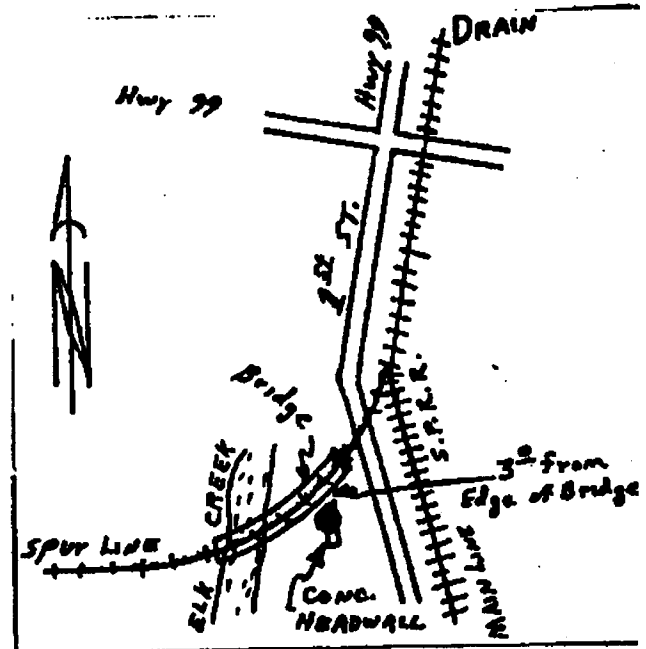

NOTE: For Possible Further Information On This Station, Please Contact The Douglas County Surveyors Office, Rm. 205 Douglas County Justice Bldg., Roseburg, OR. 97470 Phone 672-3311 Ext. 272. Douglas County residents outside the Roseburg calling area dial toll free 1-800-452-0991.