

OFFICE OF THE
DOUGLAS COUNTY SURVEYOR

Station: 26-3 T 27 S, R 6 W, Sec 14

Set By (Agency): CITY(RSBG)

Date Set: ?

Recovered By KR, TP



Date Recovered 5/82

Recovered By RWS/SST

Date Recovered 2000

Recovered By _____

Date Recovered _____

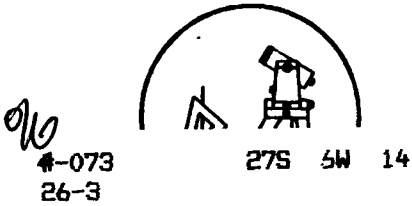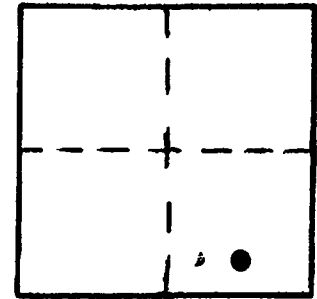

#-073
26-3

NAD 578290.16 4155293.52
83 43°13' 3" 123°22'27"

VERTICAL CONTROL NGVD 29

Elevation: ~~438.18~~ 438.17 CORPCON 6 NAVD 88 441.64 FT
NGS Line # _____ USGS Line # _____ OSHD Line # _____

Precision: 3rd Agency: CITY(RSBG) Proj. # 66/38 Date: 2000
DCSO

HORIZONTAL CONTROL OCS 27

South Zone State Plane Coordinates: Y(Northing) 578,325.30 X(Easting) 1,234,335.17

Precision: 1/20,000 Agency: DCSO Proj. # 2005-2 Date: 1983

Approximate Geographic Position: Latitude 43°13'03" Longitude 123°22'23"

DESCRIPTION and TO REACH


SKETCH

DESCRIPTION:

A 0.1 ft. diam disk stamped "26-3"
set in concrete block.

TO REACH:

Go to the NW corner of the covered
pavillion located at the intersection
of Stewart Parkway and Stewart Park Dr.

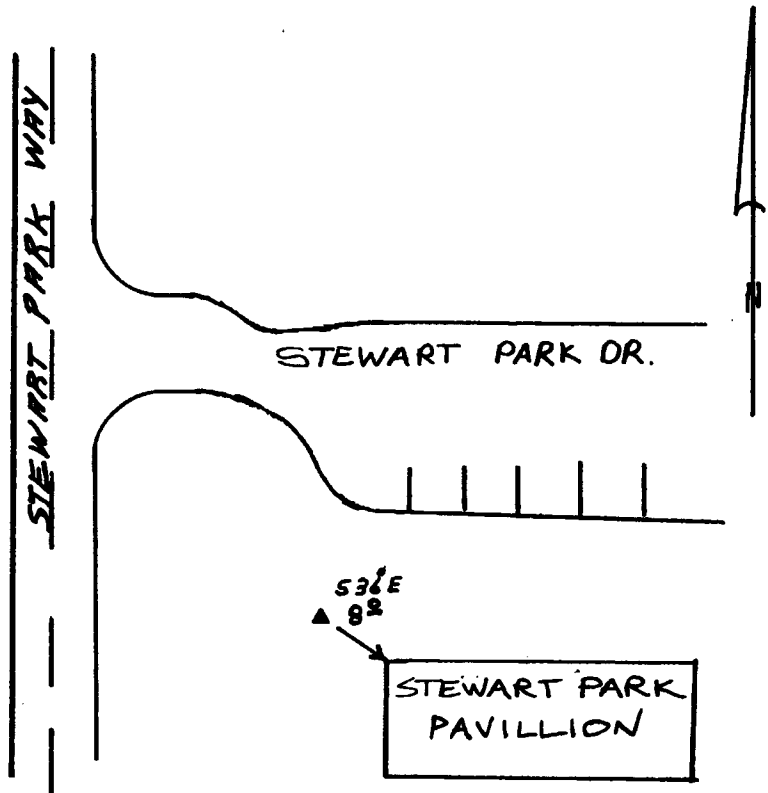

Reference Marks:

Note: For further information, contact the Douglas County Surveyor's Office, Room 205 Douglas County Justice Building, Roseburg, OR 97470. Phone 440-4278. Douglas County residents outside the Roseburg calling area, dial toll free 1-800-452-0991.