
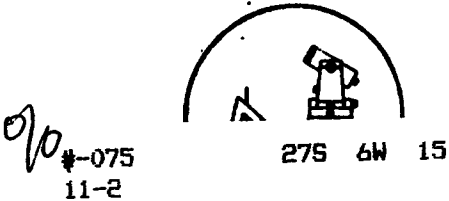


OFFICE OF THE
DOUGLAS COUNTY SURVEYOR

Station: 11-2 T 27 S, R 6 W, Sec 15
 Set By (Agency): CITY(RSBG)
 Date Set: ?
 Recovered By KR, TP
 Date Recovered 2000
 Recovered By Russ SF
 Date Recovered _____
 Recovered By _____
 Date Recovered _____

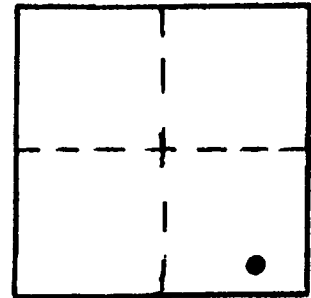

NAD 577886.89 4150768.53
 83 43°12'57" 123°23'28"

VERTICAL CONTROL NGVD 29 48 CORPCOM 6 NAVD 88 432.95 FT
 Elevation: 429.60429 NGS Line # _____ USGS Line # _____ OSHD Line # _____

Precision: 3rd Agency: CITY(RSBG) Proj. # 66/38 Date: 2000
DCSO

HORIZONTAL CONTROL DCS 27
 South Zone State Plane Coordinates: Y(Northing) 577,922.00 X(Easting) 1,229,810.15
 Precision: 1/20,000 Agency: DCSO Proj. # 2005-2 Date: 1983
 Approximate Geographic Position: Latitude 43°12'57.6" Longitude 123°23'26.6"

DESCRIPTION and TO REACH


SKETCH

DESCRIPTION:

A 0.1 ft. diam disk stamped "11-2"
set behind curbing in concrete.

TO REACH:

Go to intersection of W. Harvard Blvd.
and W. Warren Ct.

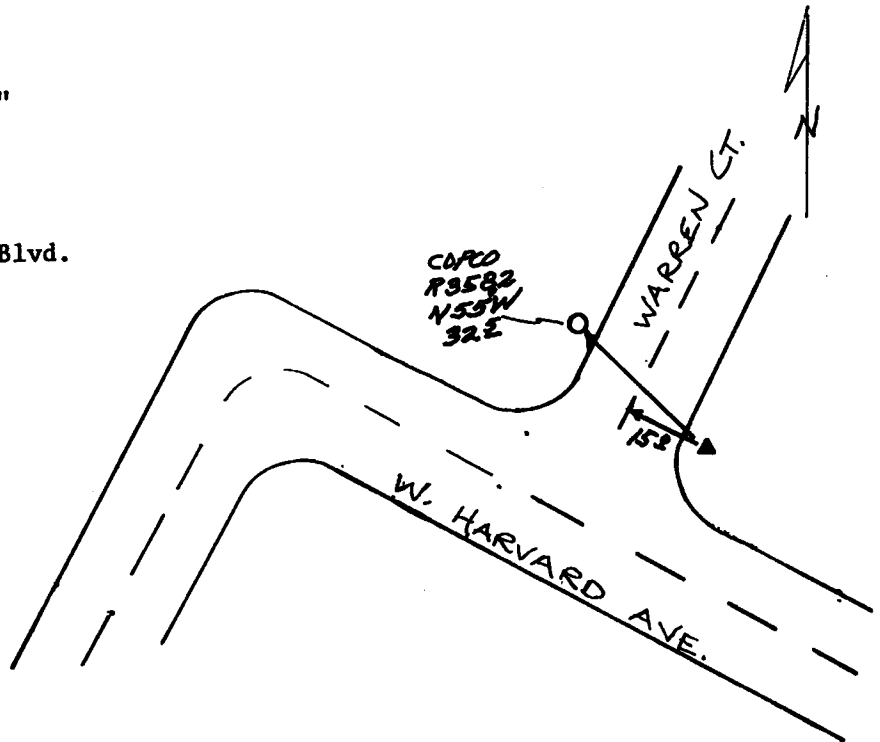

Reference Marks:

Note: For further information, contact the Douglas County Surveyor's Office, Room 205 Douglas County Justice Building, Roseburg, OR 97470. Phone 440-4278. Douglas County residents outside the Roseburg calling area, dial toll free 1-800-452-0991.