

OFFICE OF THE
DOUGLAS COUNTY SURVEYOR

Station: 10-1 T 27 S, R 6 W, Sec 22

Set By (Agency): CITY (RSBG)

Date Set: ?

Recovered By PB, RS


Date Recovered 11/3/83

Recovered By RWS-SJE

Date Recovered 2000

Recovered By _____

Date Recovered _____

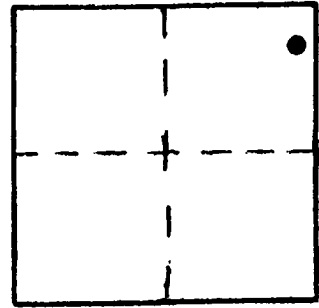

076
10-1

27S 6W 22

NAD 83 576622.00'' 4151618.50''
43°12'45'' 123°23'16''

VERTICAL CONTROL

Elevation: ~~446.22~~ 445.93 NGVD 29 CORPLONG NAVD 88 449.40 FT
NGS Line # _____ USGS Line # _____ OSHD Line # _____

Precision: 3rd Agency: ~~CITY (RSBG)~~ DCSO Proj. # 66/38 Date: 2000

HORIZONTAL CONTROL OCS 27

South Zone State Plane Coordinates: Y(Northing) 576,657.12 X(Easting) 1,230,660.11

Precision: 1/25,000 Agency: DCSO Proj. # 6012-7 CS. 59/33 Date: 1977

Approximate Geographic Position: Latitude 43°12'45.4 Longitude 123°23'11.6

DESCRIPTION and TO REACH


SKETCH

DESCRIPTION:

A disk stamped "10-1" set flush on a concrete curb.

TO REACH:

Go to the intersection of Lookinglass Rd.
(Co. Rd. #47) and Shasta Ave. in Roseburg.

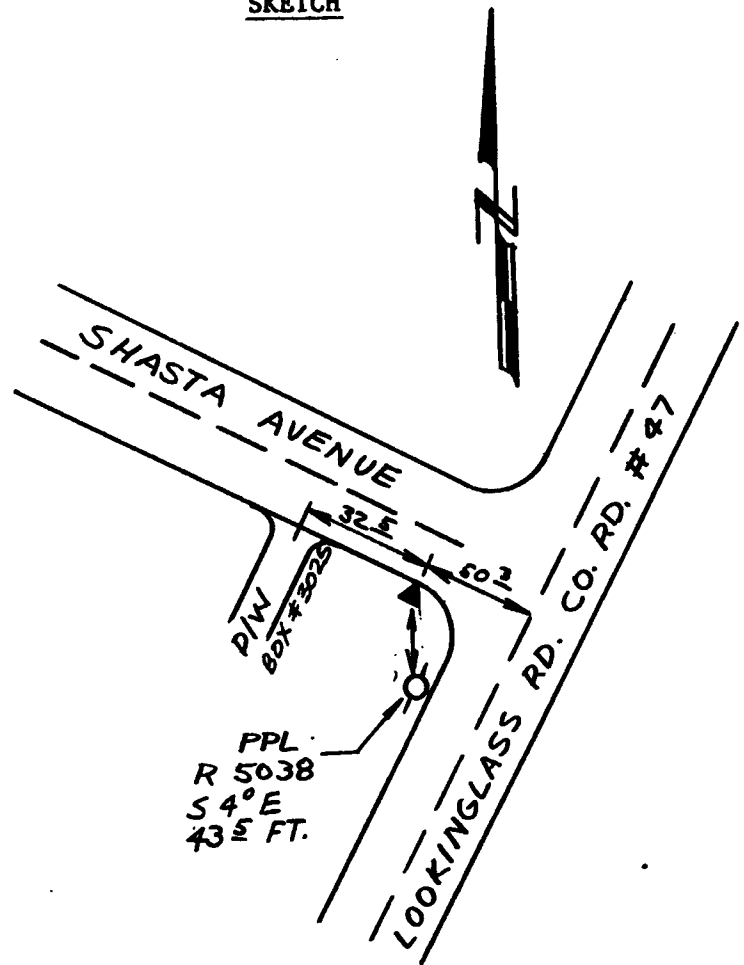

Reference Marks:

Note: For further information, contact the Douglas County Surveyor's Office, Room 205 Douglas County Justice Building, Roseburg, OR 97470. Phone 440-4278. Douglas County residents outside the Roseburg calling area, dial toll free 1-800-452-0991.