

OFFICE OF THE
DOUGLAS COUNTY SURVEYOR

Station: 10-4. T 27 S, R 6 W, Sec 22

Set By (Agency): CITY(RSBG)

Date Set: ?

Recovered By KR.TP


Date Recovered _____

Recovered By RWS SJF

Date Recovered 2000

Recovered By _____

Date Recovered _____

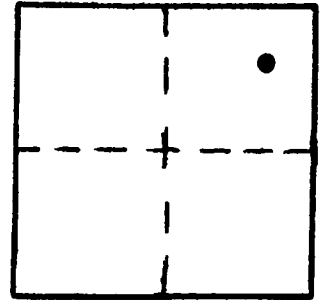

010



#-079 27S 6W 22
10-4

NAD 575278.34 4150775.58
83 43°12'31" 123°23'27"

VERTICAL CONTROL NGVD 29 CORPCON 6 NAVD 83 485.01 FT
Elevation: ~~481.65~~ 481.543 NGS Line # _____ USGS Line # _____ OSHD Line # _____
Precision: ~~3rd~~ 2nd Agency: ~~CITY(RSBG)~~ DCSO Prof. # 66/38 Date: 1990
HORIZONTAL CONTROL OCS 27

South Zone State Plane Coordinates: Y(Northing) 575,313.45 X(Easting) 1,229,817.18

Precision: 1/20,000 Agency: DCSO Proj. # 2005-2 Date: 1983

Approximate Geographic Position: Latitude 43°12'31.8 Longitude 123°23'22.4

DESCRIPTION and TO REACH


SKETCH

DESCRIPTION:

A 2 in. diam. disk stamped "10-4"
set in 6 in. sq. concrete footing.

TO REACH:

Go to intersection of Lookingglass Rd.
and W. Goedeck Ave.

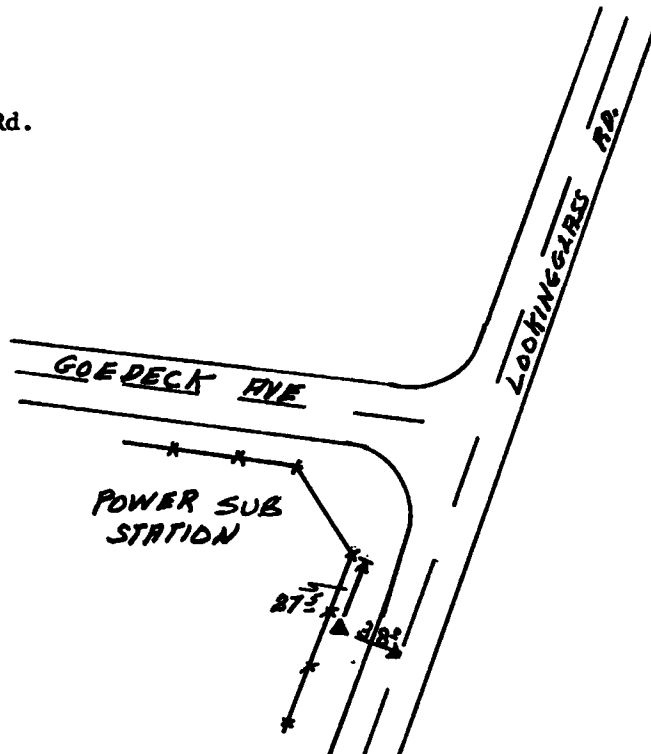

Reference Marks:

Note: For further information, contact the Douglas County Surveyor's Office, Room 205 Douglas County Justice Building, Roseburg, OR 97470. Phone 440-4278. Douglas County residents outside the Roseburg calling area, dial toll free 1-800-452-0991.