


OFFICE OF THE  
DOUGLAS COUNTY SURVEYOR

Station: 1 HJH 722 T 29 S, R 5W, Sec 23  
 Set By (Agency): USGS  
 Date Set: 1953  
 Recovered By LEM-KR  
 Date Recovered 4-82  
 Recovered By 12/92 RWS-SSP  
 Date Recovered \_\_\_\_\_  
 Recovered By \_\_\_\_\_  
 Date Recovered \_\_\_\_\_

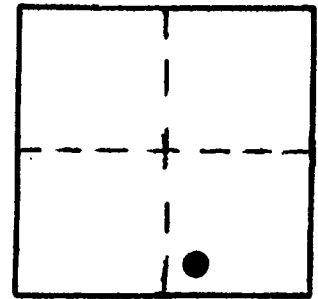

0/0  
 N  
 #-105 29S 5W 23  
 1 HJH 722  
 NAD 508554.35 4185347.67  
 83 43° 1'44" 123°15'10"


VERTICAL CONTROL NGVD 29 CORCON 6 NAVD 88 725.46 FT  
 Elevation: 722.055 NGS Line # \_\_\_\_\_ USGS Line # 145 OSHD Line # \_\_\_\_\_  
 Precision: 2nd Order Agency: DESO Proj. # 2007 Date: 1992  
HORIZONTAL CONTROL OCS 27 CS-66147  
 South Zone State Plane Coordinates: Y(Northing) 508,589.97 X(Easting) 1,264,389.21  
 Precision: 1/25,000 Agency: DCSO Proj. # 2004-16 CS 61/1 Date: 1979  
 Approximate Geographic Position: Latitude 43° 01' 45" Longitude 123° 15' 06"

DESCRIPTION and TO REACH

SKETCH

The station is a standard USGS disk set in a concrete filled 8" belltile protruding 7" above the ground stamped "1 HJH 722 1953". Disk is approx 2.5 ft. above road surface.

To Reach: At the intersection of Co. Rd. 18 (South Myrtle Rd.) and Co. Rd. 18A in S. 23 T29S, R5W.

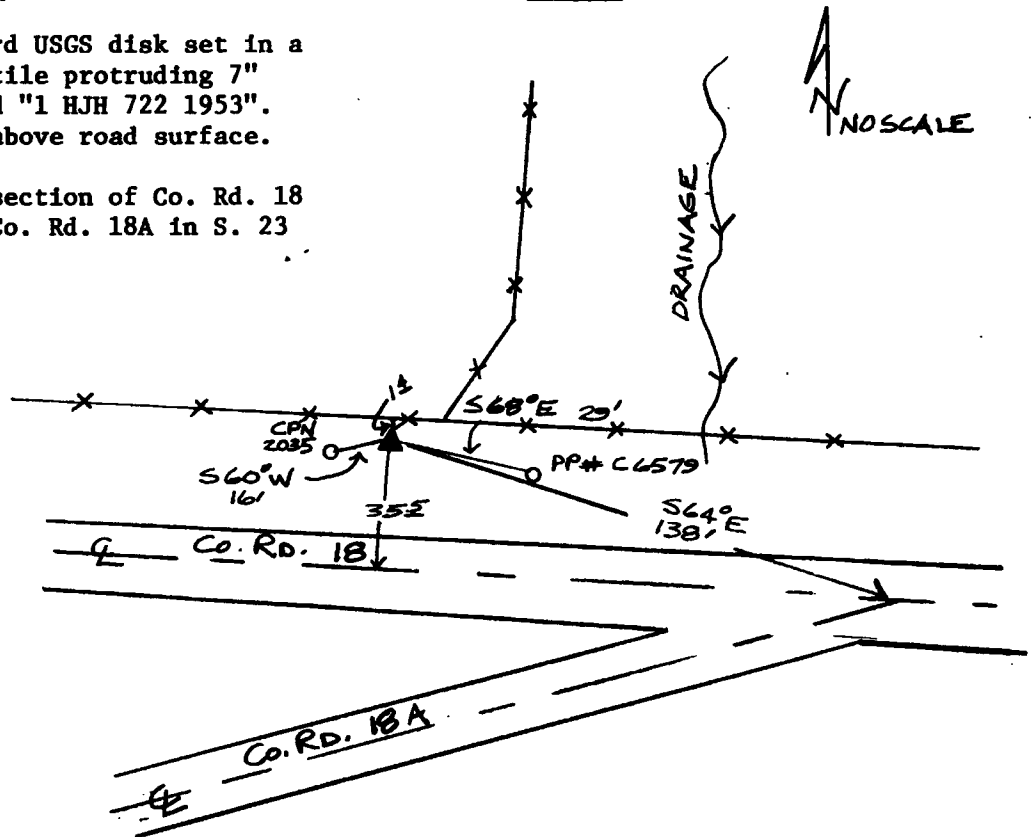

Reference Marks:

Note: For further information, contact the Douglas County Surveyor's Office, Room 205 Douglas County Justice Building, Roseburg, OR 97470. Phone 440-4278. Douglas County residents outside the Roseburg calling area, dial toll free 1-800-452-0991.