



OFFICE OF THE
DOUGLAS COUNTY SURVEYOR

Station: 14M T 29 S, R 3E, Sec 30
Set By (Agency): USGS
Date Set: 1944
Recovered By SJF, RWS
Date Recovered Aug. 14, 1987
Recovered By _____
Date Recovered _____
Recovered By _____
Date Recovered _____

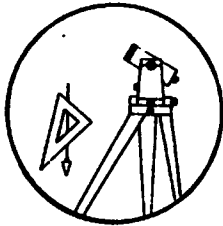

0/10
#106

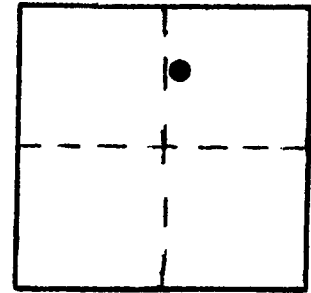

VERTICAL CONTROL NGVD 29 CORPCON 6 NAVD 88 4182.14 FT
Elevation: 4178.67 ft. NGS Line # _____ USGS Line # 143 OSHD Line # _____
Precision: 3rd. order Agency: USGS Proj. # _____ Date: 1965

HORIZONTAL CONTROL
South Zone State Plane Coordinates: Y(Northing) _____ X(Easting) _____
Precision: _____ Agency: _____ Proj. # _____ Date: _____
Approximate Geographic Position: Latitude _____ Longitude _____


DESCRIPTION and TO REACH

SKETCH

A 3 1/4 inch diameter U.S.G.S. disk stamped "14M 4179 1944" set in top of 6x4x3 foot high boulder.

TO REACH:

From the intersection of U.S.F.S. Rd. #2947 (400) and spur road 430 in T29S, R3E, Section 30 proceed westerly along spur road 430 approximately 350 feet to monument on left.

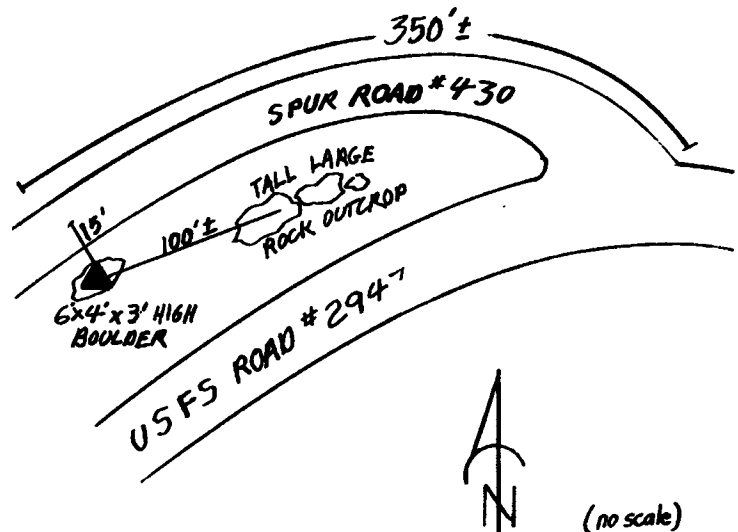

Reference Marks:

Note: For further information, contact the Douglas County Surveyor's Office, Room 205 Douglas County Justice Building, Roseburg, OR 97470. Phone 440-4278. Douglas County residents outside the Roseburg calling area, dial toll free 1-800-452-0991.