

615

DOUGLAS COUNTY SURVEYOR'S OFFICE


R 032716 A OFFSET 170° 75 FT TO MON.

Designation: #125 Station: 5-10.4 T 275 R 7W S 31 1/4 SE

Date Set: 1982 Set by (Agency): DCPW

Date Recovered: 3-27-03 Recovered by: KWS SJF

- Found, New, Reset, Not Found, Referenced, Destroyed

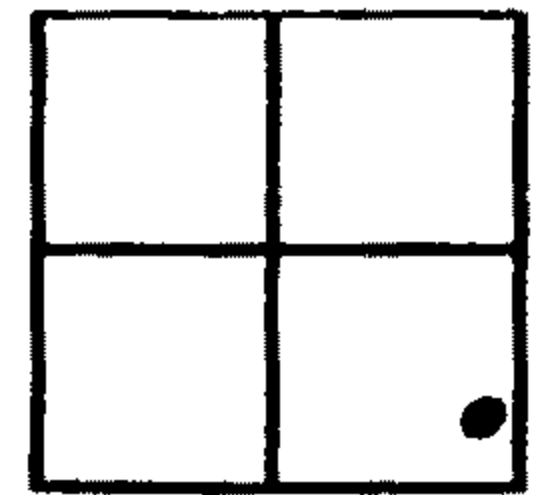

VERTICAL CONTROL

NGVD 29 Elevation: 716.654 Feet File #
Precision: 2nd Agency: DCPW Project: CS 66/61 Date: 1982
NAVD 88 Elevation: 720.141 Meters File #
Precision: CORPCON 6 NAVD 88 Agency: Project: Date:

HORIZONTAL CONTROL - south zone

N E Datum/Adj.: 1927 Precision: 615
Lat: 43° 10' 29.3" Long: 123° 33' 54.0" Agency: File # Date:
N E Datum/Adj.: Precision:
Lat: Long: Agency: File # Date:
N E Datum/Adj.: Precision:
Lat: Long: Agency: File # Date:
N E Datum/Adj.: Precision:
Lat: Long: Agency: File # Date:

DESCRIPTION AND TO REACH

A DCPW DISK STAMPED "5-10.4
BM 1982" SET IN A 6 1/2" DIA.
CONCRETE FILLED PLASTIC PIPE,
PROTRUDING 2" OUT OF GROUND.
FROM THE INTERSECTION OF RESTON
ROAD (CO. RD #5) AND FLOURNOY
VALLEY ROAD (CO. RD #51) IN T275,
R7W, SEC. 32. PROCEED SOUTHWESTERLY
ALONG RESTON ROAD APPROXIMATELY
0.9 MILES TO INCUMBENT ON LEFT.

