

OFFICE OF THE
DOUGLAS COUNTY SURVEYOR

Station: 6M RESET T 28 S, R 4E, Sec 35

Set By (Agency): USC & GS

Date Set: 1969

Recovered By DCSO


Date Recovered 8-12-86

Recovered By _____

Date Recovered _____

Recovered By _____

Date Recovered _____

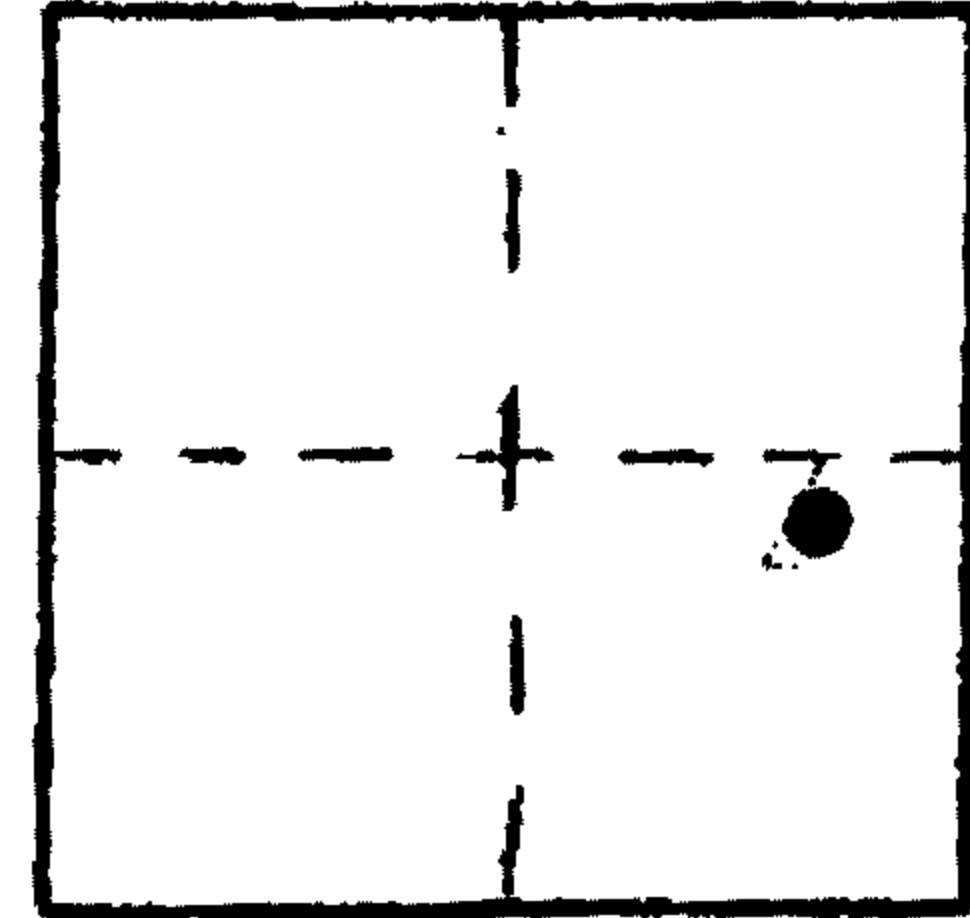

0/0
#128

VERTICAL CONTROL NGVD 29 CORPCON 6 NAVD 88 4413.702 FT

Elevation: 4409.460 NGS Line # 128 USGS Line # _____ OSHD Line # _____

Precision: 2nd Agency: USC&GS Proj. # 2013 Date: 1969

HORIZONTAL CONTROL

South Zone State Plane Coordinates: Y(Northing) _____ X(Easting) _____

Precision: _____ Agency: _____ Proj. # _____ Date: _____

Approximate Geographic Position: Latitude _____ Longitude _____

DESCRIPTION and TO REACH


SKETCH

9.45 miles west of intersection
of new Highway 230 with new
Highway 138. in T28S, R5 1/2E, Sec. 21



Brass Cap in Concrete Monument,
3" above ground with witness post.

Reference Marks:

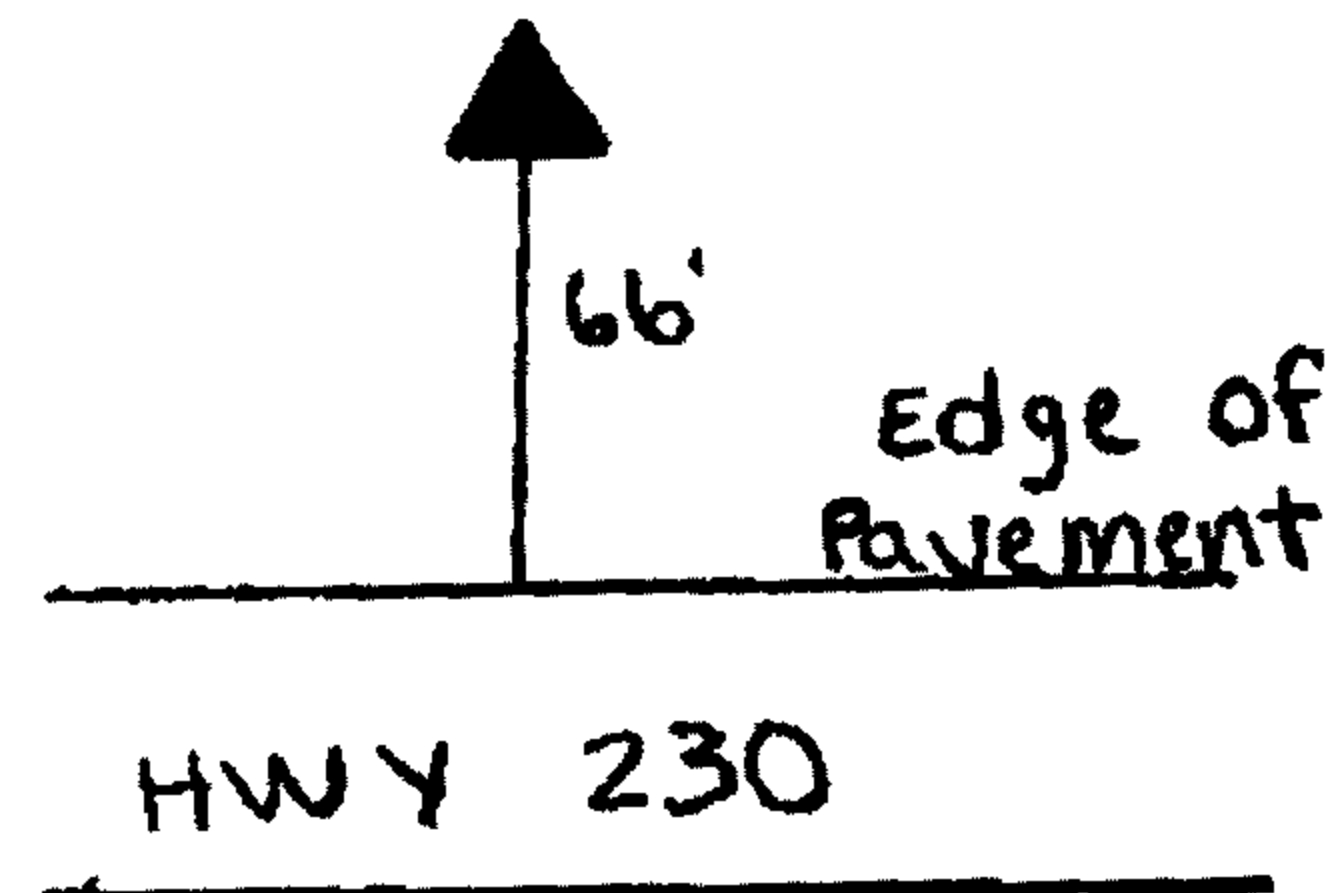

Note: For further information, contact the Douglas County Surveyor's Office, Room 205 Douglas County Justice Building, Roseburg, OR 97470. Phone 440-4278. Douglas County residents outside the Roseburg calling area, dial toll free 1-800-452-0991.