



OFFICE OF THE  
DOUGLAS COUNTY SURVEYOR

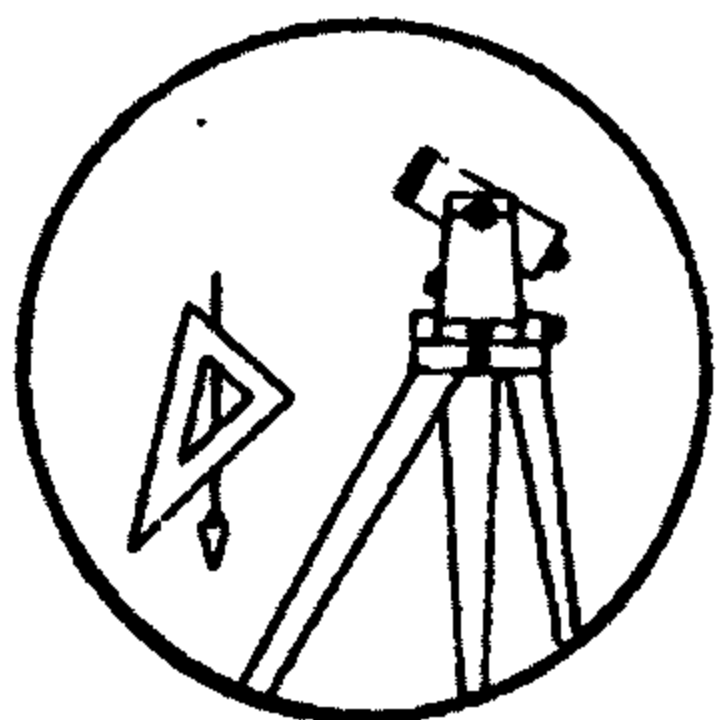

0/0 #.131

Station: 9 T 29 S, R 4E , Sec 29  
 Set By (Agency): BPR  
 Date Set: 1939  
 Recovered By DCSO  
 Date Recovered 8-12-86  
 Recovered By \_\_\_\_\_  
 Date Recovered \_\_\_\_\_  
 Recovered By \_\_\_\_\_  
 Date Recovered \_\_\_\_\_

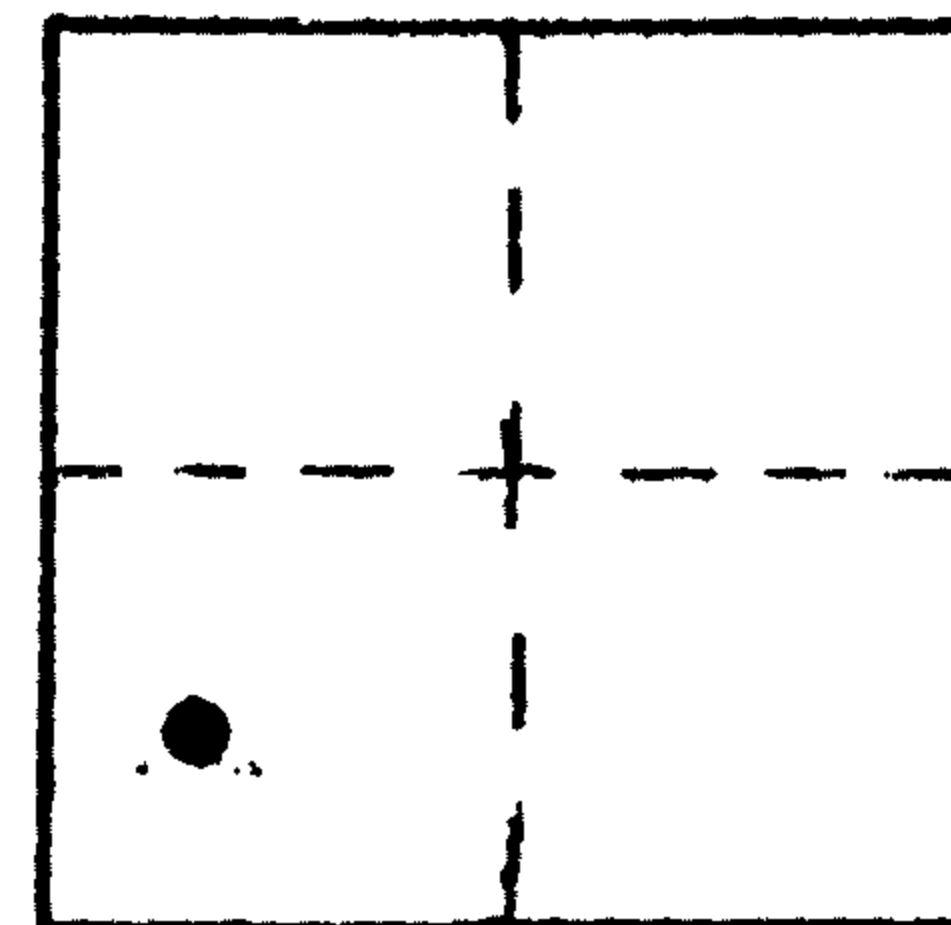

VERTICAL CONTROL NGVD 29 CORPCON 6 NAVD 88 3859.785 FT  
 Elevation: 3855.701 NGS Line # 128 USGS Line # \_\_\_\_\_ OSHD Line # \_\_\_\_\_  
 Precision: 2nd Agency: USC&GS Proj. # 2013 Date: 1957

HORIZONTAL CONTROL  
 South Zone State Plane Coordinates: Y(Northing) \_\_\_\_\_ X(Easting) \_\_\_\_\_  
 Precision: \_\_\_\_\_ Agency: \_\_\_\_\_ Proj. # \_\_\_\_\_ Date: \_\_\_\_\_  
 Approximate Geographic Position: Latitude \_\_\_\_\_ Longitude \_\_\_\_\_


DESCRIPTION and TO REACH

4.7 miles Southwest of the  
 intersection of the Forest Service  
 roads 6530 & 6560 with Highway 230.  
 in T29S,R4E,Sec.3.

SKETCH



Brass Cap in concrete monument,  
 4" above ground with witness post.

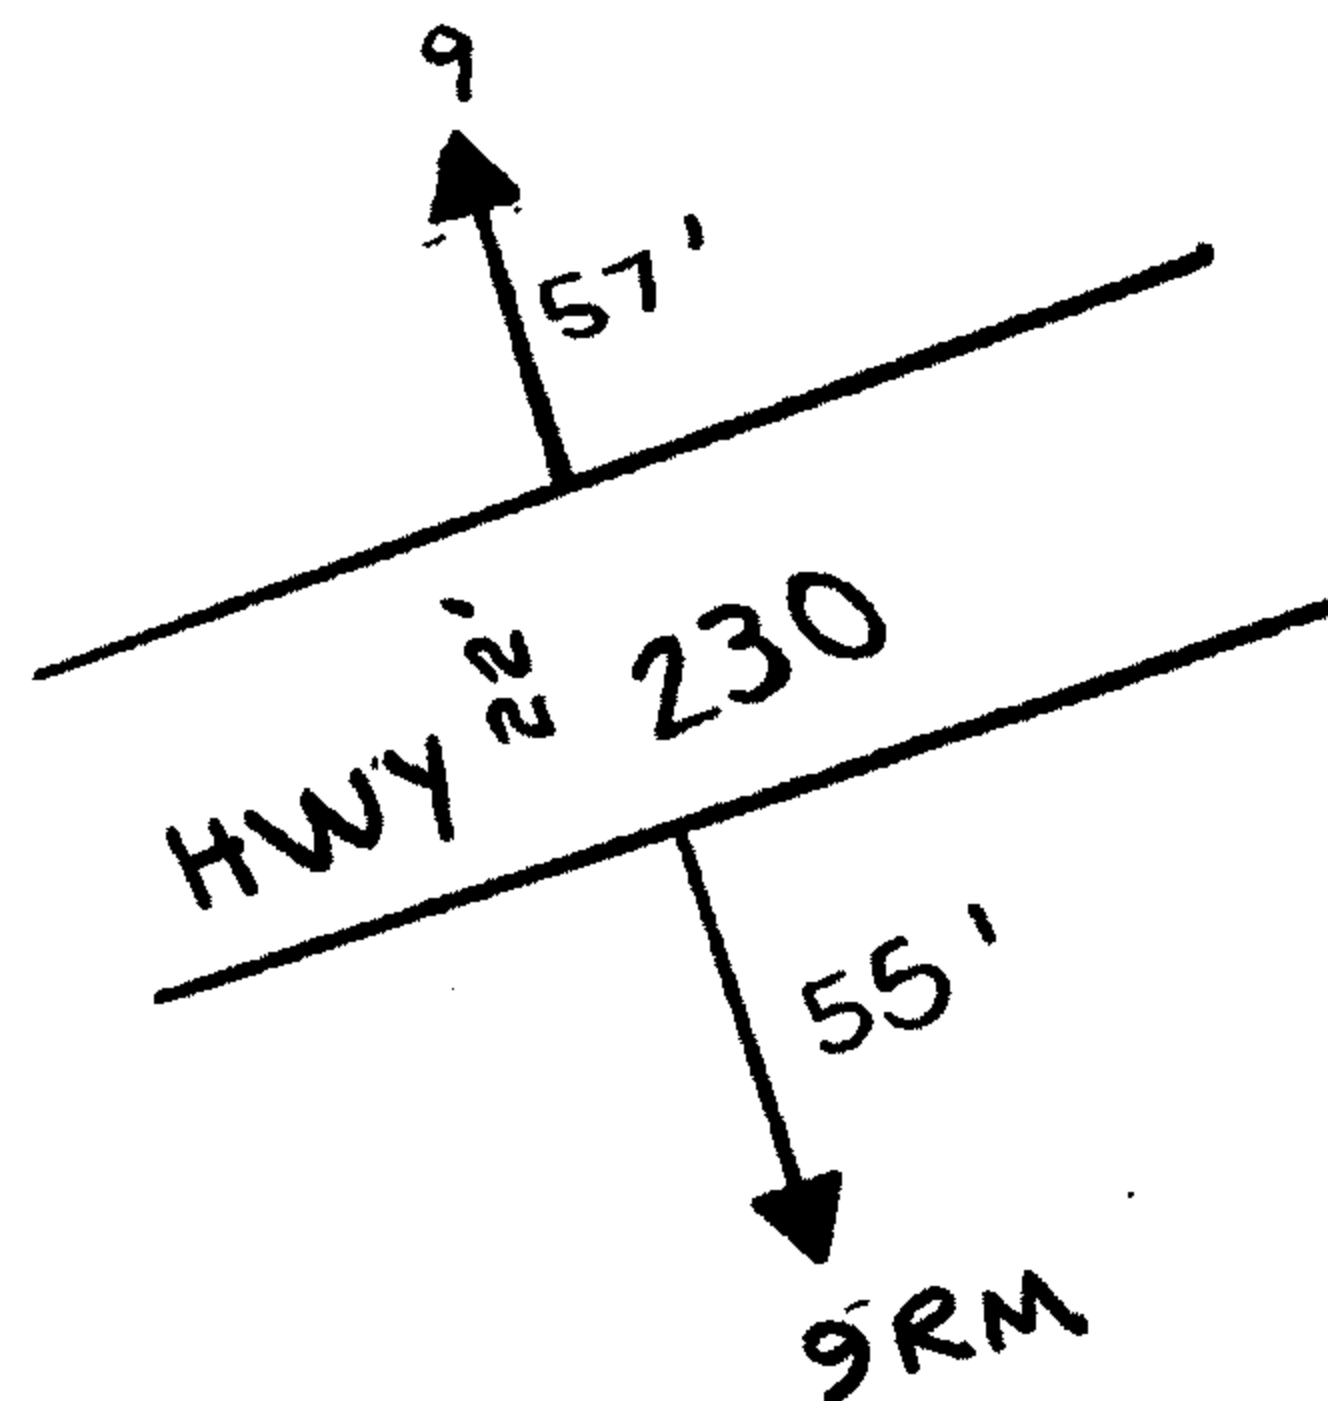

Reference Marks:

Note: For further information, contact the Douglas County Surveyor's Office, Room 205  
 Douglas County Justice Building, Roseburg, OR 97470. Phone 440-4278. Douglas  
 County residents outside the Roseburg calling area, dial toll free 1-800-452-0991.