



OFFICE OF THE
DOUGLAS COUNTY SURVEYOR

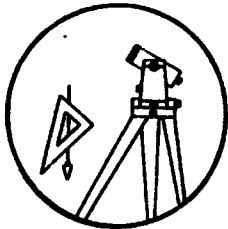

010#-133

Station: 1M 1944 1199 T 30 S, R 2W , Sec 22
 Set By (Agency): USGS
 Date Set: 1944
 Recovered By TP-JP
 Date Recovered 4-28-82
 Recovered By _____
 Date Recovered _____
 Recovered By _____
 Date Recovered _____

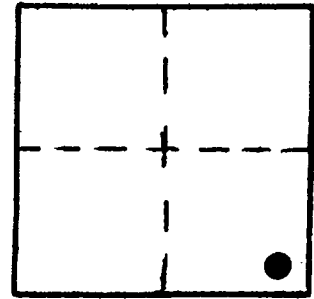

VERTICAL CONTROL NGVD 29 CORPCON 88 NAVD 88 1202.48 FT

Elevation: 1199.02 NGS Line # _____ USGS Line # 114 OSHD Line # _____
 Precision: 3rd Agency: USGS Proj. # _____ Date: 1956

HORIZONTAL CONTROL


South Zone State Plane Coordinates: Y(Northing) _____ X(Easting) _____
 Precision: _____ Agency: _____ Proj. # _____ Date: _____
 Approximate Geographic Position: Latitude _____ Longitude _____

DESCRIPTION and TO REACH

Found: A standard USGS Disk set in exposed bedrock stamped "1M 1944 1199"; set 15' above road surface on high cut bank.

To reach: From the intersection of St.Hwy. #227 and Co.Rd. #46 in (sec. 33 T30S R2W) proceed Northerly along Co. Rd. #46 2.1 mi. to monument on the left.

SKETCH

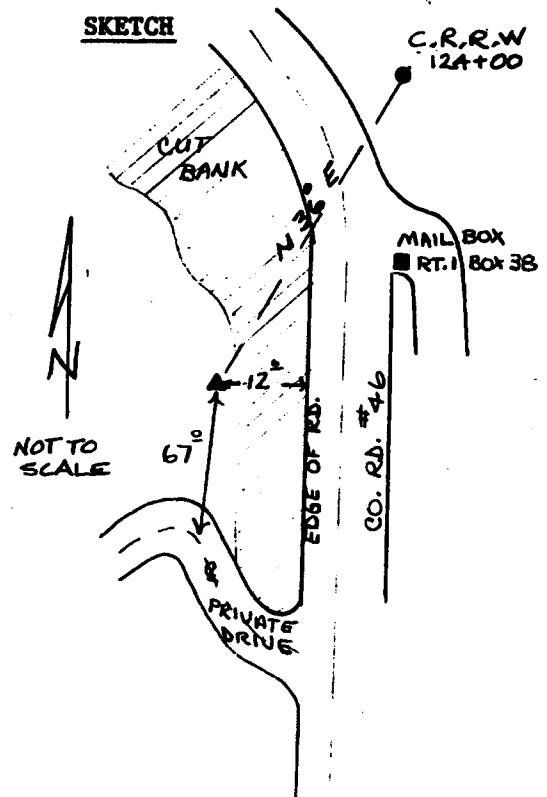

Reference Marks:

Note: For further information, contact the Douglas County Surveyor's Office, Room 205 Douglas County Justice Building, Roseburg, OR 97470. Phone 440-4278. Douglas County residents outside the Roseburg calling area, dial toll free 1-800-452-0991.