



OFFICE OF THE
DOUGLAS COUNTY SURVEYOR

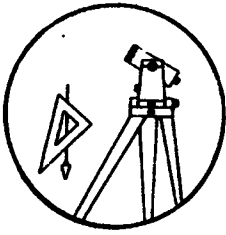

Station: 15M T 29 S, R 3E, Sec 17
 Set By (Agency): USGS
 Date Set: 1944
 Recovered By RWS, SJF
 Date Recovered 8/17/87
 Recovered By _____
 Date Recovered _____
 Recovered By _____
 Date Recovered _____

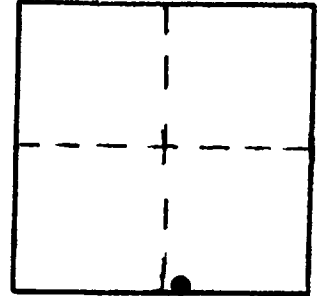

dp #139

VERTICAL CONTROL NGVD29 CORPCON 6 NAVD88 4933.84 FT
 Elevation: 4929.76 ft. NGS Line # _____ USGS Line # 142 OSHD Line # _____
 Precision: 3rd order Agency: USGS Proj. # _____ Date: 1965

HORIZONTAL CONTROL
 South Zone State Plane Coordinates: Y(Northing) _____ X(Easting) _____
 Precision: _____ Agency: _____ Proj. # _____ Date: _____
 Approximate Geographic Position: Latitude _____ Longitude _____


DESCRIPTION and TO REACH

SKETCH

A USGS disk stamped "15M 1944" set in a small rock outcrop.

TO REACH:

From the intersection of USFS Roads #422, #450 and #400 in T29S, R3E, Sec. 20, proceed southerly 0.1 mi. along USFS Rd. #422 to Cripple Creek trail head, proceed northeasterly along Cripple Creek trail approx. 0.75 miles to Cripple Creek shelter, monument is easterly of shelter approx. 300 ft.

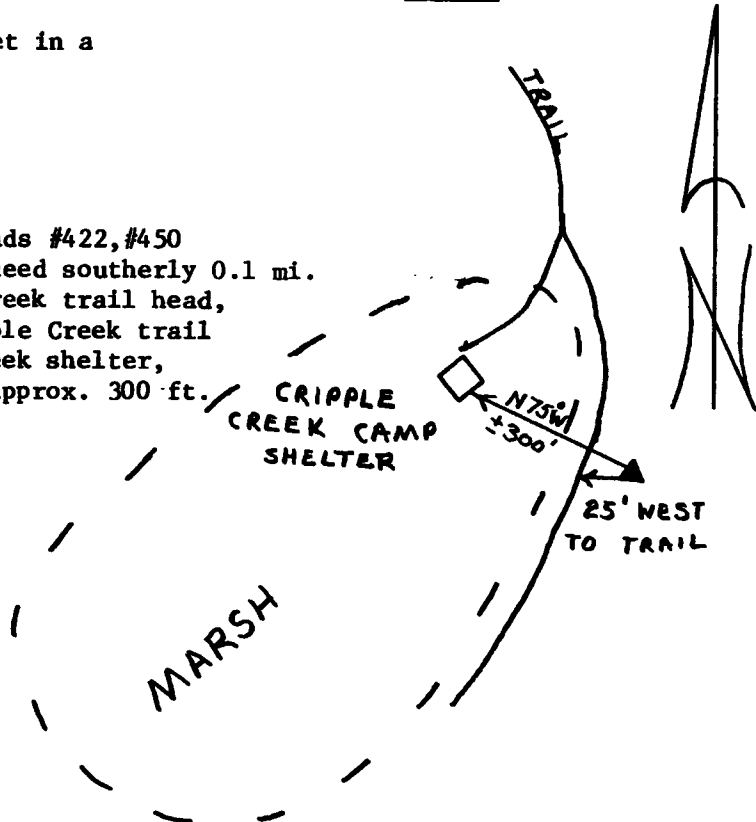

Reference Marks:

Note: For further information, contact the Douglas County Surveyor's Office, Room 205 Douglas County Justice Building, Roseburg, OR 97470. Phone 440-4278. Douglas County residents outside the Roseburg calling area, dial toll free 1-800-452-0991.