


OFFICE OF THE
DOUGLAS COUNTY SURVEYOR

Station: SE Cor
Date Set: 1963
Set By (Agency): BLM
Date Recovered: 2/25/92
Recovered By: RWS, SJF, JP
Date Recovered: _____
Recovered By: _____
Date Recovered: _____
Recovered By: _____

T 22 S, R 6W , Sec 27

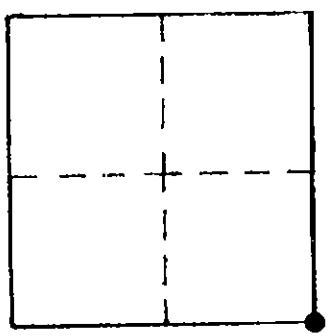

220-06W-27-060 225 06W 27
SE CORNER
NAD 725557.18 4156684.60
83 43°37'17" 123°23'17"

VERTICAL CONTROL

Elevation: 1203.9 NGS Line # _____ USGS Line # _____ OSHD Line # _____
Precision: GPS Agency: DCSO Proj. # 2015 Date: 1992

HORIZONTAL CONTROL

South Zone O.C.S. 27: Y(Northing) 725,592.14 X(Easting) 1,235,724.23
South Zone O.C.S. 83: Y(Northing) _____ X(Easting) _____
Precision: 1/5000 Agency: DCSO Proj. # 2015 Date: 1992
Approx. NAD 83 Geographic Position: Latitude _____ Longitude _____

DESCRIPTION and TO REACH

SKETCH

SEE DOUGLAS COUNTY SURVEYORS OFFICE RECORDS OF GOVERNMENT CORNERS RENEWED.

Reference Marks:

Note: For further information, contact the Douglas County Surveyor's Office, Room 205 Douglas County Justice Building, Roseburg, OR 97470. Phone 440-4278. Douglas County residents outside the Roseburg calling area, dial toll free 1-800-452-0991.