

OFFICE OF THE
DOUGLAS COUNTY SURVEYOR

Station: SE COR. SEC. 7 T 22 S, R 12 W, Sec 7

Set By (Agency): DCSO

Date Set: 1986

Recovered By _____



Date Recovered _____

Recovered By _____

Date Recovered _____

Recovered By _____

Date Recovered _____

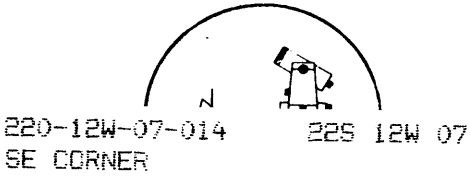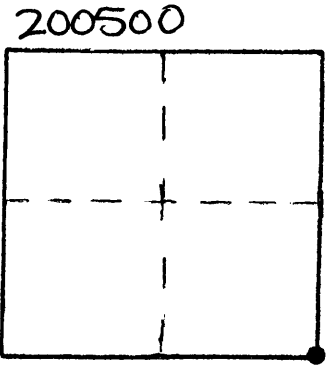

NAD 750747.76 3952080.39
83 43°40' 6" 124° 9'51"

VERTICAL CONTROL

Elevation: _____ NGS Line # _____ USGS Line # _____ OSHD Line # _____

Precision: _____ Agency: _____ Proj. # _____ Date: _____

HORIZONTAL CONTROL **NAD 27**

South Zone State Plane Coordinates: Y(Northing) 750,782.83 X(Easting) 1,031,119.67

Precision: 1/5,000 Agency: DCSO Proj. # 6009-12, CS62/43 Date: 1986

Approximate Geographic Position: Latitude 43°40'07" Longitude 124°09'47"

DESCRIPTION and TO REACH

SKETCH

SEE DCSO CORNER RENEWAL RECORDS.

Reference Marks:

Note: For further information, contact the Douglas County Surveyor's Office, Room 205 Douglas County Justice Building, Roseburg, OR 97470. Phone 440-4278. Douglas County residents outside the Roseburg calling area, dial toll free 1-800-452-0991.