



OFFICE OF THE
DOUGLAS COUNTY SURVEYOR

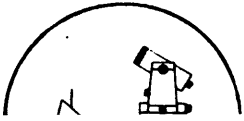

220-12W-08-018 22S 12W 08
SE CORNER

NAD 750462.83 3957257.15
83 43°40' 6" 124° 8'40"

Station: SE cor. T 22 S, R 12 W , Sec 8
Set By (Agency): DCSO 300500
Date Set: 10/82
Recovered By GEQ
Date Recovered 4/83
Recovered By _____
Date Recovered _____
Recovered By _____
Date Recovered _____
Recovered By _____
Date Recovered _____

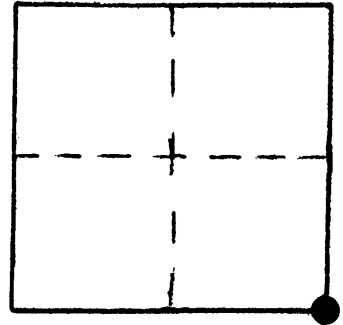

VERTICAL CONTROL

Elevation: _____ NGS Line # _____ USGS Line # _____ OSHD Line # _____
Precision: _____ Agency: _____ Proj. # _____ Date: _____

HORIZONTAL CONTROL NAD 27

South Zone State Plane Coordinates: Y(Northing) 750,497.90 X(Easting) 1,036,296.44
Precision: 1/5,000 Agency: DCSO Proj. # 6004-16 Date: 1983
Approximate Geographic Position: Latitude 43°40'06" Longitude 124°08'36"

DESCRIPTION and TO REACH

SKETCH

Monument is a 1"x30" iron pipe with a brass cap attached stamped "Douglas Co. Surveyor T22S S8 S9 S17 S16 R12W 1982". See Douglas Co. Surveyor records for renewed corners for more information.

Reference Marks:

Note: For further information, contact the Douglas County Surveyor's Office, Room 205 Douglas County Justice Building, Roseburg, OR 97470. Phone 440-4278. Douglas County residents outside the Roseburg calling area, dial toll free 1-800-452-0991.