

OFFICE OF THE
DOUGLAS COUNTY SURVEYOR

Station: RM 2, E1/4 S 1 T 22 S, R 12 W, Sec 1

Set By (Agency): DCSO

Date Set: Jan. 9, 1990

Recovered By RWS, SJF


Date Recovered Jan. 18, 1990

Recovered By _____

Date Recovered _____

Recovered By _____

Date Recovered _____

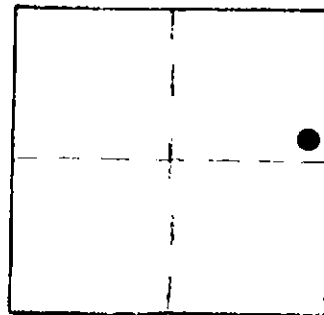

220-12W-01-056 22S 12W 01
RM 2 E 1/4

NAD 757911.38 3978764.98
83 43°41'28" 124°03'52"

VERTICAL CONTROL

Elevation: N/A NGS Line # _____ USGS Line # _____ OSHD Line # _____

Precision: _____ Agency: _____ Proj. # _____ Date: _____

HORIZONTAL CONTROL

South Zone State Plane Coordinates: Y(Northing) 757,946.46 X(Easting) 1,057,804.26

Precision: 1/25,000 Agency: DCSO Proj. # 2015 Date: 1990

Approximate Geographic Position: Latitude 43°41'29" Longitude 124°03'48"

DESCRIPTION and TO REACH

A DCSO 3 inch diameter
drill cap stamped

" DOUGLAS CO. SURVEYORS "

T22S
RM 2
R R
12 S1 | S6 11
W 1990 W


OFFICE

set flush in sandstone 6 inches
below ground surface.

TO REACH:

From the intersection of Schofield
Road (Co.Rd.#55) and State Highway 38 in
T22S, R12W, Sec. 1 proceed southeasterly along
State Highway 38 approximately 700 ft. to
monument on right.

SKETCH

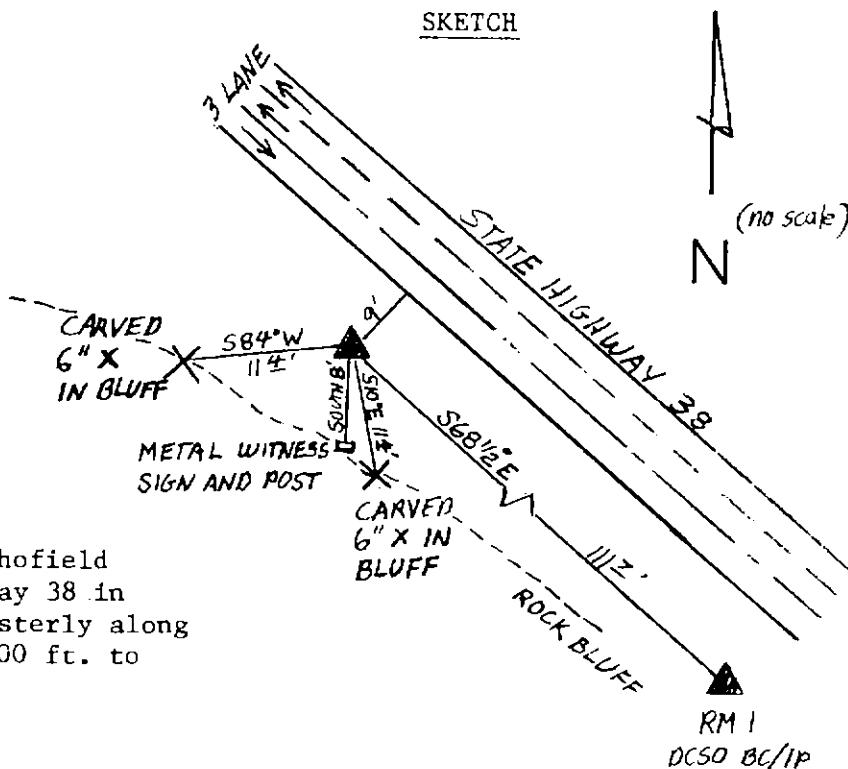

Reference Marks:

Note: See RM 1 E 1/4 Section 1 and M 42-27

Note: For further information, contact the Douglas County Surveyor's Office, Room 205
Douglas County Justice Building, Roseburg, OR 97470. Phone 440-4278. Douglas
County residents outside the Roseburg calling area, dial toll free 1-800-452-0991.