

OFFICE OF THE
DOUGLAS COUNTY SURVEYOR

Station: SW COR.

T 23 S, R 4 W , Sec 31

Date Set: 1981

Set By (Agency): RLS 1654

Date Recovered: 11/2/90



Recovered By: SJF, TF

Date Recovered: _____

Recovered By: _____

Date Recovered: _____

Recovered By: _____

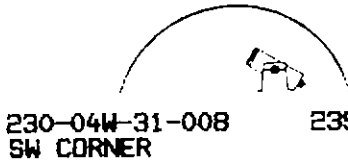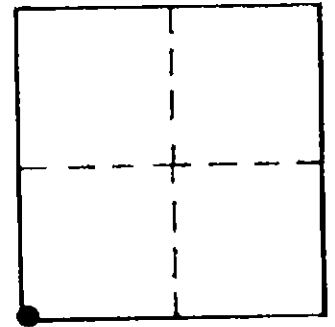

~~230-04W-31-008~~ 23S 04W 31
SW CORNER

NAD 686866.38 4197985.64
83 43°31' 9" 123°13'39"

VERTICAL CONTROL

Elevation: _____ NGS Line # _____ USGS Line # _____ OSHD Line # _____

Precision: _____ Agency: _____ Proj. # _____ Date: _____

HORIZONTAL CONTROL

South Zone O.C.S. 27: Y(Northing) 686,901.03 X(Easting) 1,277,025.62

South Zone O.C.S. 83: Y(Northing) _____ X(Easting) _____

Precision: 1/5,000 Agency: DCSO Proj. # 2015 Date: 1990

Approx. NAD 83 Geographic Position: Latitude _____ Longitude _____

DESCRIPTION and TO REACH

SKETCH

SEE DCSO CORNER RENEWAL RECORDS.

Reference Marks:

Note: For further information, contact the Douglas County Surveyor's Office, Room 205 Douglas County Justice Building, Roseburg, OR 97470. Phone 440-4278. Douglas County residents outside the Roseburg calling area, dial toll free 1-800-452-0991.