

OFFICE OF THE
DOUGLAS COUNTY SURVEYOR

Station: SW COR SEC 1

T 24 S, R 5 W, Sec 1

Date Set: 1960

Set By (Agency): DCSO

Date Recovered: 3/5/91


Recovered By: RWS, S.JF, TF

Date Recovered: _____

Recovered By: _____

Date Recovered: _____

Recovered By: _____

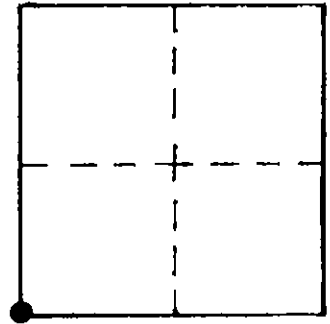

240-05W-01-020 24S 05W 01
SW CORNER

NAD 681733.16 4192566.30
83 43°30'16" 123°14'50"

VERTICAL CONTROL

Elevation: _____ NGS Line # _____ USGS Line # _____ OSHD Line # _____

Precision: _____ Agency: _____ Proj. # _____ Date: _____

HORIZONTAL CONTROL

South Zone O.C.S. 27: Y(Northing) 681,767.48 X(Easting) 1,271,606.45

South Zone O.C.S. 83: Y(Northing) _____ X(Easting) _____

Precision: 1/5,000 Agency: DCSO Proj. # 2015 Date: 1991

Approx. NAD 83 Geographic Position: Latitude _____ Longitude _____

DESCRIPTION and TO REACH

SKETCH

SEE DCSO CORNER RENEWAL RECORDS.

Reference Marks:

Note: For further information, contact the Douglas County Surveyor's Office, Room 205 Douglas County Justice Building, Roseburg, OR 97470. Phone 440-4278. Douglas County residents outside the Roseburg calling area, dial toll free 1-800-452-0991.