

OFFICE OF THE  
DOUGLAS COUNTY SURVEYOR

056020

Station: NW COR. DLC 56 T 27 S, R 6 W, Sec 13

Set By (Agency): DCSO

Date Set: 8/28/84

Recovered By LEM,RS


Date Recovered 8/28/84

Recovered By \_\_\_\_\_

Date Recovered \_\_\_\_\_

Recovered By \_\_\_\_\_

Date Recovered \_\_\_\_\_

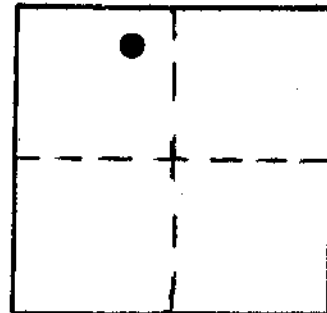

270-06W-13-004 27S 06W 13  
NW DLC 56

NAD 83 581541.84 4159436.82  
43°13'36" 123°21'33"

VERTICAL CONTROL

Elevation: \_\_\_\_\_ NGS Line # \_\_\_\_\_ USGS Line # \_\_\_\_\_ OSHD Line # \_\_\_\_\_

Precision: \_\_\_\_\_ Agency: \_\_\_\_\_ Proj. # \_\_\_\_\_ Date: \_\_\_\_\_

HORIZONTAL CONTROL **OCS 27**

South Zone State Plane Coordinates: Y(Northing) 581,577.00 X(Easting) 1,238,478.50

Precision: 1/5,000 Agency: DCSO Proj. # 0001, CS 62/22 Date: 1984

Approximate Geographic Position: Latitude 43°13'37" Longitude 123°21'28"

DESCRIPTION and TO REACH

SKETCH

DESCRIPTION:

A DCSO disk stamped "T27S R6W DLC 65  
DLC 56 1984" set 5 in. below asphalt  
in a 5 in. dia. 21 in. long concrete filled  
metal water box.


TO REACH:

Go to the intersection of Mulholland Dr.  
and NW Garden Valley Blvd. in Roseburg  
Oregon (T27S,R6W,Sec.13) monument is  
approx. 75 ft. east of intersection.

NOTE: See DCSO Corner Renewal Record.

Reference Marks:

A DCSO disk stamped "I-DID 1972"  
bears N86°33'36"W, 410.95 ft. (grid).

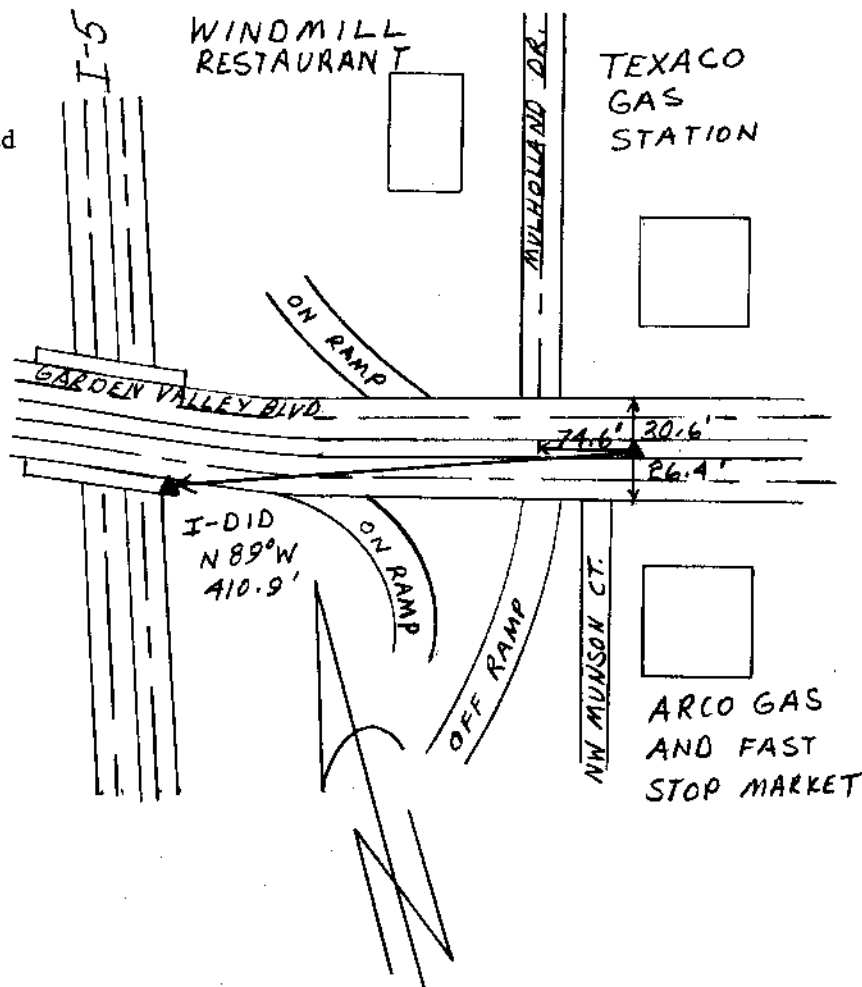

Note: For further information, contact the Douglas County Surveyor's Office, Room 205  
Douglas County Justice Building, Roseburg, OR 97470. Phone 440-4278. Douglas  
County residents outside the Roseburg calling area, dial toll free 1-800-452-0991.