



OFFICE OF THE
DOUGLAS COUNTY SURVEYOR

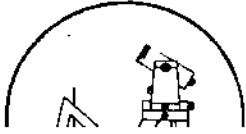

280-03W-31-014 28S 03W 31
SW CORNER
NAD 527412.81 4224248.62
83 43° 5' 3" 123° 6' 35"

Station: SW COR 100100 T 28 S, R 3 W , Sec 31
Set By (Agency): BLM
Date Set: 1964
Recovered By RWS, SJF
Date Recovered 9/15/89
Recovered By _____
Date Recovered _____
Recovered By _____
Date Recovered _____

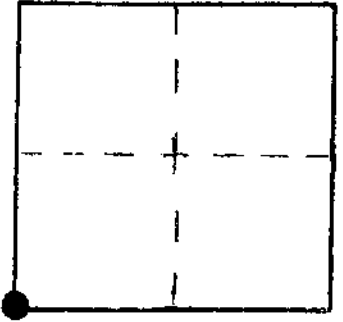

VERTICAL CONTROL

Elevation: _____ NGS Line # _____ USGS Line # _____ OSHD Line # _____
Precision: _____ Agency: _____ Proj. # _____ Date: _____

HORIZONTAL CONTROL **OCS 27**

South Zone State Plane Coordinates: Y(Northing) 527,448.77 X(Easting) 1,303,290.27
Precision: 1/5,000 Agency: DCSO Proj. # 0002 Date: 1989
Approximate Geographic Position: Latitude 43°05'03" Longitude 123°06'31"

DESCRIPTION and TO REACH

SKETCH

See Douglas County Surveyor's record of
government corners renewed.

Reference Marks:

Note: For further information, contact the Douglas County Surveyor's Office, Room 205
Douglas County Justice Building, Roseburg, OR 97470. Phone 440-4278. Douglas
County residents outside the Roseburg calling area, dial toll free 1-800-452-0991.