

OFFICE OF THE  
DOUGLAS COUNTY SURVEYOR

Station: SE COR., SEC. 32 T 32 S, R 6 W, Sec 32

Set By (Agency): DCSO

Date Set: 1967

Recovered By JP, RS



Date Recovered 8/16/83

Recovered By \_\_\_\_\_

Date Recovered \_\_\_\_\_

Recovered By \_\_\_\_\_

Date Recovered \_\_\_\_\_

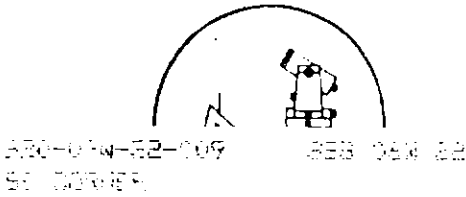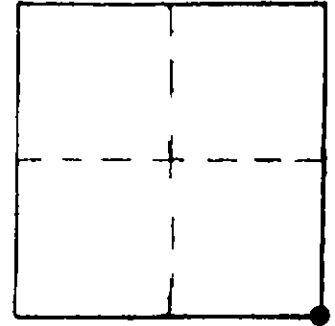

ARC-044-82-009 823 044 82  
SE CORNER

VERTICAL CONTROL

Elevation: \_\_\_\_\_ NGS Line # \_\_\_\_\_ USGS Line # \_\_\_\_\_ OSHD Line # \_\_\_\_\_  
Precision: \_\_\_\_\_ Agency: \_\_\_\_\_ Proj. # \_\_\_\_\_ Date: \_\_\_\_\_

HORIZONTAL CONTROL

South Zone State Plane Coordinates: Y(Northing) 404,815.07 X(Easting) 1,214,297.22  
Precision: 1/5,000 Agency: DCSO Proj. # 0002 Date: 1974  
Approximate Geographic Position: Latitude 42°44'23" Longitude 123°25'31"

DESCRIPTION and TO REACH

SKETCH


DESCRIPTION:

A DCSO disk stamped "S32 S33 T32S R6W S5 T33S R6W 1967"

TO REACH:

From the intersection of Pacific Hwy (Co.Rd.#175) and Third St. in Glendale, proceed northerly along Third St. across SPRR to the end of Third St. turn left and go approx. 125 ft. to monument on right.

\* See DCSO Corner Renewal Notes.

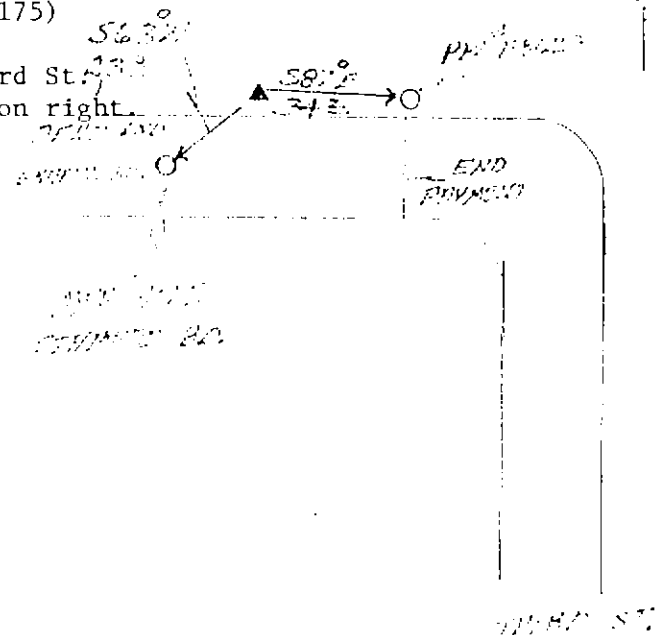

Reference Marks:

Note: For further information, contact the Douglas County Surveyor's Office, Room 205 Douglas County Justice Building, Roseburg, OR 97470. Phone 440-4278. Douglas County residents outside the Roseburg calling area, dial toll free 1-800-452-0991.