

OFFICE OF THE
DOUGLAS COUNTY SURVEYOR

A-013




A-013
A 266

NAD 716906.69 418456.08
83 43°36' 1" 123°16' 56"

Station: A266
Set By (Agency): USC&GS
Date Set: 1934
Recovered By RWS,SJF
Date Recovered 9/14/87
Recovered By _____
Date Recovered _____
Recovered By _____
Date Recovered _____

T 23 S, R 5 W , Sec 3

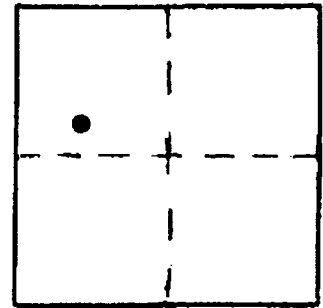

VERTICAL CONTROL

Elevation: 354.462 NGS Line # 6 USGS Line # _____ OSHD Line # _____
Precision: 1st Agency: USC&GS Proj. # _____ Date: 1957

CORPCONG NAVD88 358.046 FT

HORIZONTAL CONTROL

South Zone State Plane Coordinates: Y(Northing) 716,941.37 X(Easting) 1,263,495.77
Precision: 1/15,000 Agency: DCSO Proj. # 2008 Date: 1979
Approximate Geographic Position: Latitude 43°36'01" Longitude 123°16'51"

DESCRIPTION and TO REACH

A USC&GS disk stamped "A266 354 1934"
set in a 1ft. square concrete post
protruding 6 in. above ground.

TO REACH:

Go to the intersection of Main St. and
State Hwy 99 in T23S,R5W,Sec.3(YONCALLA)
monument is northeast of intersection.


* NOTE:

Monument has been disturbed, use with
caution.

Reference Marks:

MAIN ST.

SKETCH

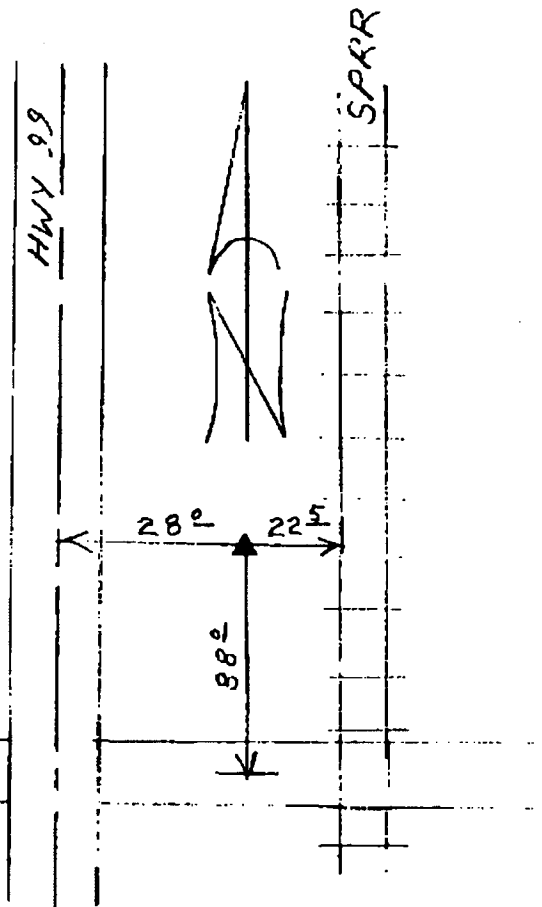

Note: For further information, contact the Douglas County Surveyor's Office, Room 205
Douglas County Justice Building, Roseburg, OR 97470. Phone 440-4278. Douglas
County residents outside the Roseburg calling area, dial toll free 1-800-452-0991.