


A-042

OFFICE OF THE
DOUGLAS COUNTY SURVEYOR

8-042
ALEX

888 124 7

NAE 784502.39 3947872.39
39 497407.02 124107.91

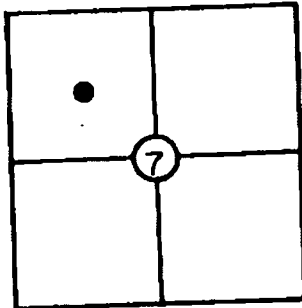

T 22 S, R 12 W, Sec. 7

Station: ALEX

Set By (Agency): DCSO

Date: 1980

*CORPCON 6 NAVD 88
14.853 FT*

VERTICAL CONTROL

Elevation: 11.275 NGS(USC&GS) Line # _____ USGS Line # _____

Order Of Precision 2nd Agency: DCSO Proj. #: 2007 CS 61/16 Date: 1981

HORIZONTAL CONTROL

Oregon State Plane Coordinates: Y(Northing) 754,537.53 X(Easting) 1,027,012.72
(South Zone)

Order Of Precision 1/15,000 Agency: DCSO Proj. #: 2008 Date: 1980
(C.S. 61/16)

Approximate Geographic Position: Latitude= 43° 40' 42" Longitude= 124° 10' 45"

DESCRIPTION: Station mark is a standard DCSO

brass cap stamped "ALEX 1980" set in conc.


curb of parking area near sidewalk down the

middle of peninsula dividing East and West

Bays of harbor.

VICINITY: SALMON HARBOR

SKETCH

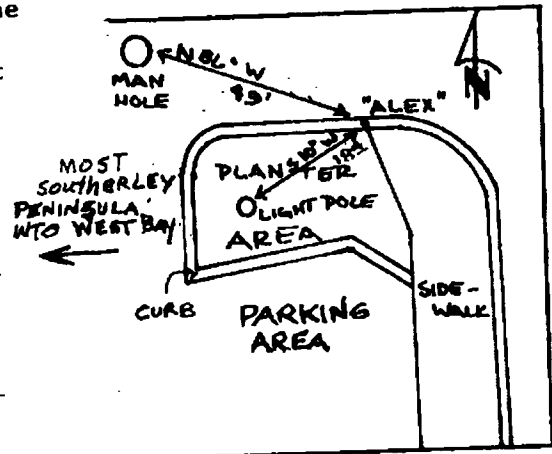

NOTE: For Possible Further Information On This Station, Please Contact The Douglas County Surveyors Office, Rm. 205 Douglas County Justice Bldg., Roseburg, OR. 97470 Phone 672-3311 Ext. 272. Douglas County residents outside the Roseburg calling area dial toll free 1-800-452-0991.