

OFFICE OF THE
DOUGLAS COUNTY SURVEYOR

Station: ANT. T 27 S, R 2 W, Sec 3

Set By (Agency): DCSO

Date Set: 1974

Recovered By RWS, SJF


Date Recovered 11/19/84

Recovered By TF

Date Recovered 1-30-92

Recovered By RWS - SJF 10/1999

Date Recovered _____

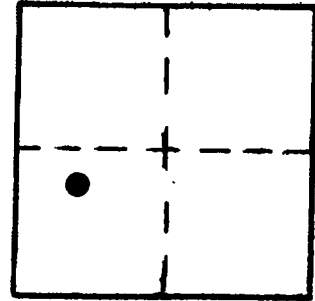

a-051
ANT

27S 2W 3

NAD 585805.29 4274753.34
83 43°14'54" 122°55'37"

NGVD 29
VERTICAL CONTROL

Elevation: 1163.8 1164.52 NGS Line # _____ USGS Line # _____ OSHD Line # _____
Precision: GPS 3rd Agency: DCSO Proj. # 2000 CS66/56 Date: 1992 1999

HORIZONTAL CONTROL

South Zone State Plane Coordinates: Y(Northing) 585,841.76 X(Easting) 1,353,793.69
Precision: 1/25,000 Agency: DCSO Proj. # 2004-1,2004-23 Date: 1974
Approximate Geographic Position: Latitude 43°14'55" Longitude 122°55'33"


DESCRIPTION and TO REACH

SKETCH

A DCSO disk stamped "ANT 1974" set flush in the northeast corner of a concrete bridge over little river.

TO REACH:

Go to the intersection of Little River Rd. (Co. Rd. #17) and USFS Rd. #2701.

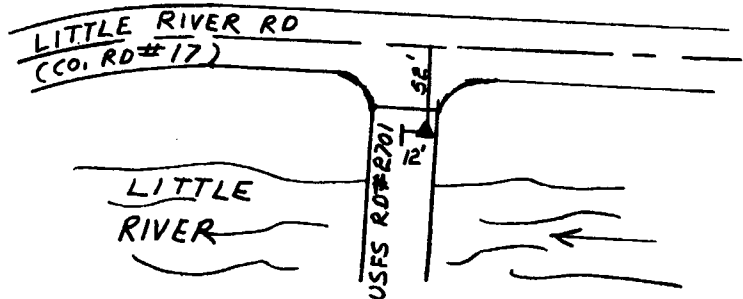

Reference Marks:

Note: For further information, contact the Douglas County Surveyor's Office, Room 205 Douglas County Justice Building, Roseburg, OR 97470. Phone 440-4278. Douglas County residents outside the Roseburg calling area, dial toll free 1-800-452-0991.