



OFFICE OF THE
DOUGLAS COUNTY SURVEYOR

Station: A-5 T 29 S, R 4E, Sec 31
Set By (Agency): B P R
Date Set: ?
Recovered By DCSO
Date Recovered 8-12-86
Recovered By _____
Date Recovered _____
Recovered By _____
Date Recovered _____

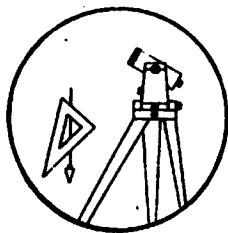

A-065

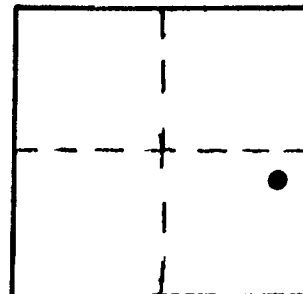

VERTICAL CONTROL NGVD 29 CORPCON 6 NAVD 88 3764.538 FT
Elevation: 3760.485 NGS Line # 128 USGS Line # _____ OSHD Line # _____
Precision: 2nd Agency: USC&GS Proj. # 2013 Date: 1957


HORIZONTAL CONTROL

South Zone State Plane Coordinates: Y(Northing) _____ X(Easting) _____
Precision: _____ Agency: _____ Proj. # _____ Date: _____
Approximate Geographic Position: Latitude _____ Longitude _____

DESCRIPTION and TO REACH

SKETCH

5.7 miles southwest of the
intersection of Forest Service
roads 6530 & 6560 with Highway 230
in T29S,R4E,Sec.3

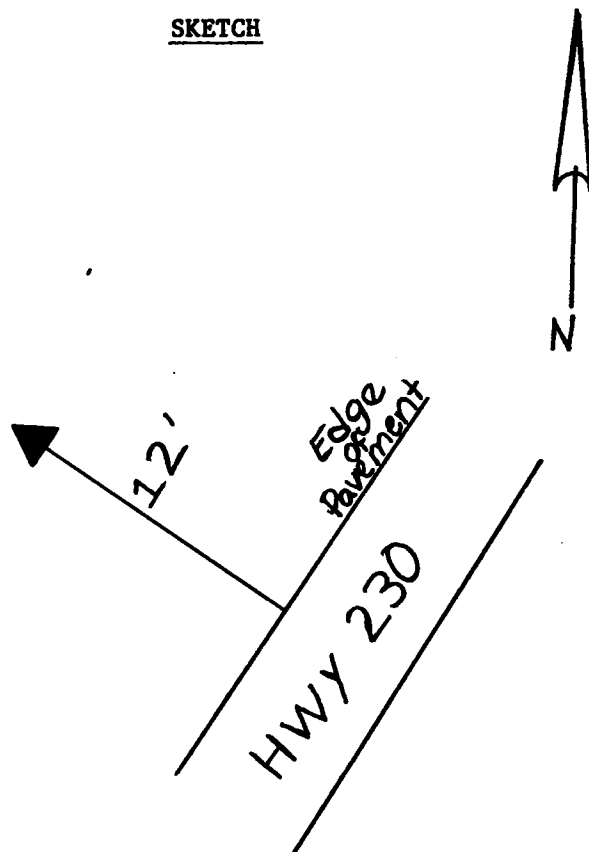

Brass Cap in concrete monument flush
with ground with witness post.

Reference Marks:

Note: For further information, contact the Douglas County Surveyor's Office, Room 205
Douglas County Justice Building, Roseburg, OR 97470. Phone 440-4278. Douglas
County residents outside the Roseburg calling area, dial toll free 1-800-452-0991.