

OFFICE OF THE
DOUGLAS COUNTY SURVEYOR

Station: A-7 T 29 S, R 4 E, Sec 16

Set By (Agency): BPR

Date Set: ?

Recovered By DCSO



Date Recovered 8-12-86

Recovered By _____

Date Recovered _____

Recovered By _____

Date Recovered _____

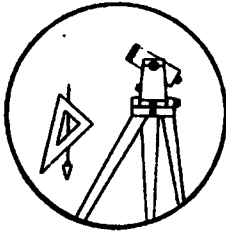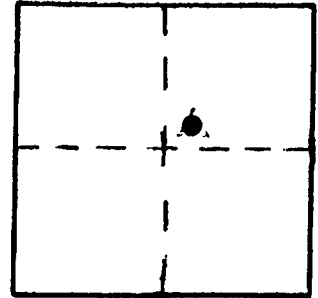

A-7

VERTICAL CONTROL NGVD 29 CORPCON 6 NAVD88 3952.968 FT

Elevation: 3948.906 NGS Line # 128 USGS Line # _____ OSHD Line # _____

Precision: 2nd Agency: USC&GS Proj. # 2013 Date: 1957

HORIZONTAL CONTROL

South Zone State Plane Coordinates: Y(Northing) _____ X(Easting) _____


Precision: _____ Agency: _____ Proj. # _____ Date: _____

Approximate Geographic Position: Latitude _____ Longitude _____

DESCRIPTION and TO REACH

1.65 miles Southwest of the
intersection of Forest Service
Roads 6530 & 6560 with Highway
230. in T29S,R4E,Sec.3.

SKETCH

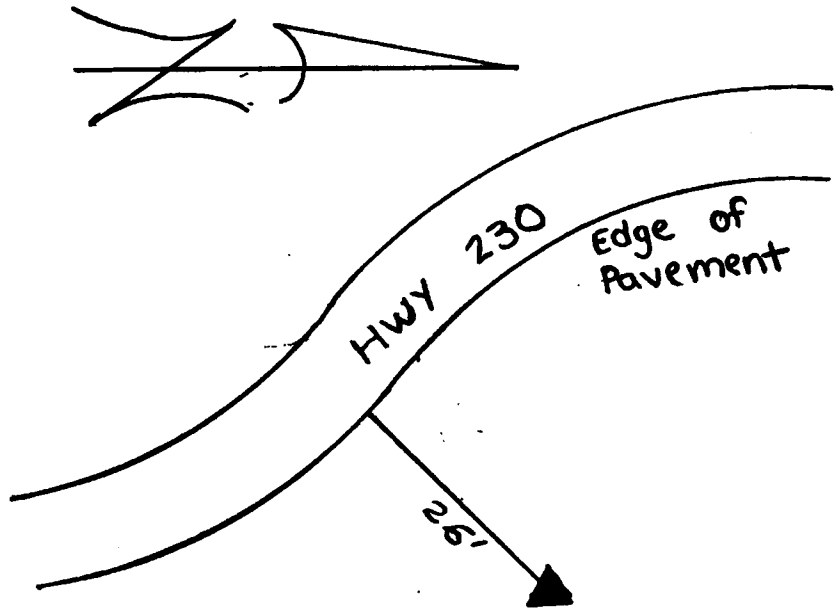

Brass Cap in Concrete Monument
3" above ground with witness
post.

Reference Marks:

Note: For further information, contact the Douglas County Surveyor's Office, Room 205 Douglas County Justice Building, Roseburg, OR 97470. Phone 440-4278. Douglas County residents outside the Roseburg calling area, dial toll free 1-800-452-0991.