
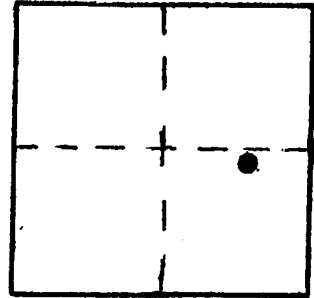


OFFICE OF THE
DOUGLAS COUNTY SURVEYOR

Station: A-10 T 29 S, R 4E, Sec 9
 Set By (Agency): BPR
 Date Set: ?
 Recovered By DCSO
 Date Recovered 8-12-86
 Recovered By _____
 Date Recovered _____
 Recovered By _____
 Date Recovered _____

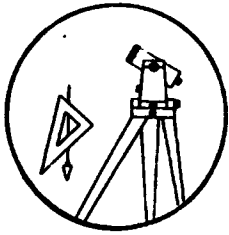

A-70

VERTICAL CONTROL NGVD 29 CORPCON 6 NAVD88 4092.001 FT

Elevation: 4087.905 NGS Line # 128 USGS Line # _____ OSHD Line # _____
 Precision: 2nd Agency: USC&GS Proj. # 2013 Date: 1957

HORIZONTAL CONTROL


South Zone State Plane Coordinates: Y(Northing) _____ X(Easting) _____
 Precision: _____ Agency: _____ Proj. # _____ Date: _____
 Approximate Geographic Position: Latitude _____ Longitude _____

DESCRIPTION and TO REACH

1.0 miles Southwest of the
 intersection of Forest Service
 Roads 6530 & 6560 with
 Highway 230. in T29S,R4E,Sec.3.

SKETCH

Brass Cap in Concrete Monument,
 3" above ground with witness post.

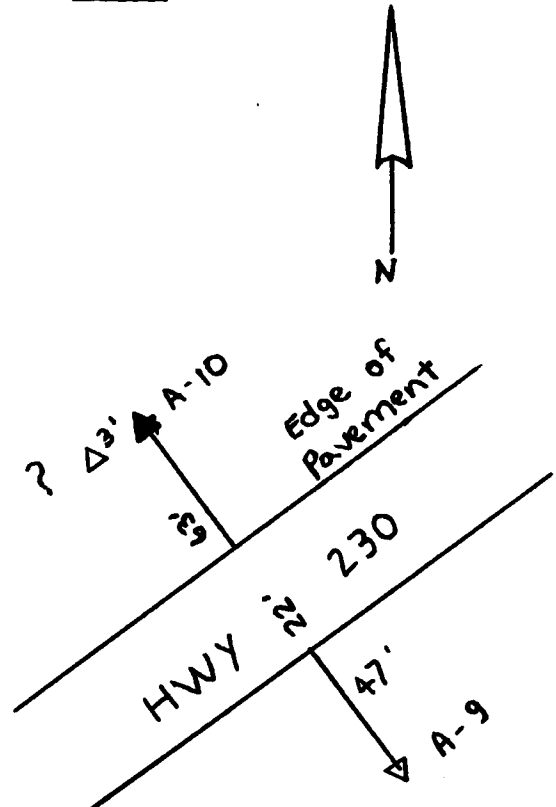

Reference Marks:

Note: For further information, contact the Douglas County Surveyor's Office, Room 205 Douglas County Justice Building, Roseburg, OR 97470. Phone 440-4278. Douglas County residents outside the Roseburg calling area, dial toll free 1-800-452-0991.