



OFFICE OF THE
DOUGLAS COUNTY SURVEYOR

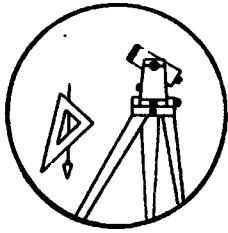

A-072

Station: A 16-RESET T 28 S, R 5E, Sec 33
Set By (Agency): USC&GS
Date Set: 1969
Recovered By DCSO
Date Recovered 8-12-86
Recovered By _____
Date Recovered _____
Recovered By _____
Date Recovered _____

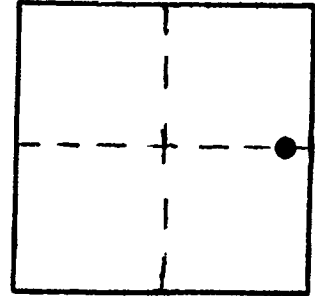

VERTICAL CONTROL NGVD 29 CORPCOM 6 NAVD 88 5199,726 FT
Elevation: 5195.339 NGS Line # 128 USGS Line # _____ OSHD Line # _____
Precision: 2nd Agency: USC&GS Proj. # 2013 Date: 1969

HORIZONTAL CONTROL
South Zone State Plane Coordinates: Y(Northing) _____ X(Easting) _____
Precision: _____ Agency: _____ Proj. # _____ Date: _____
Approximate Geographic Position: Latitude _____ Longitude _____

DESCRIPTION and TO REACH


5.45 miles west of intersection
of new Highway 230 with new
Highway 138. in T28S,R5 1/2E,
Sec.21.

SKETCH



Brass Cap in concrete monument
4" above ground with witness post.

Reference Marks:

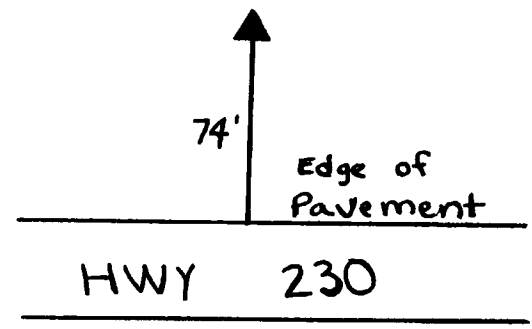

Note: For further information, contact the Douglas County Surveyor's Office, Room 205
Douglas County Justice Building, Roseburg, OR 97470. Phone 440-4278. Douglas
County residents outside the Roseburg calling area, dial toll free 1-800-452-0991.