
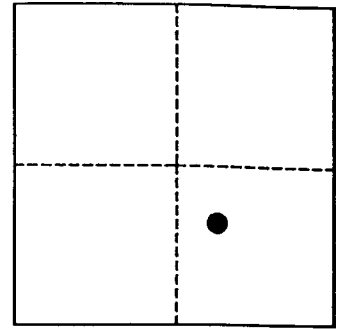


OFFICE OF THE  
DOUGLAS COUNTY SURVEYOR

Station: A 743  
 Date Set: 1987  
 Set By (Agency): NGS  
 DCSO Designation: A-080  
 Date Recovered: 8-93  
 Recovered By: S.JF RWS  
 Date Recovered: \_\_\_\_\_  
 Recovered By: \_\_\_\_\_  
 Date Recovered: \_\_\_\_\_  
 Recovered By: \_\_\_\_\_

T30W R9W Sec. 10

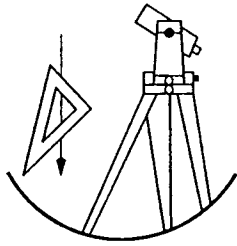

VERTICAL CONTROL

~~NAVD 88~~  
~~NAVD 29~~ Elevation: 805.315 FEET      NAVD 88 Elevation: 245.460 METERS  
 NGS Line # 125034    USGS LINE # \_\_\_\_\_    OSHD Line # \_\_\_\_\_    FILE # \_\_\_\_\_  
 Precision: 1ST ORDER    Agency: NGS    Proj: \_\_\_\_\_    Date: 1988

HORIZONTAL CONTROL

O.C.S. 27    Y(Northing): \_\_\_\_\_    O.C.S. 83    Y(Northing): 493097  
 (South Zone)    X(Easting): \_\_\_\_\_    (South Zone)    X(Easting): 4051959  
 Precision: GIS SCALED Agency: DCSO    Proj: \_\_\_\_\_    Date: 2014  
 Approx. O.C.S. 27 Geographic Position:    Latitude: 42°58'24"    Longitude: 123°45'03"  
 Approx. O.C.S. 83 Geographic Position:    Latitude: \_\_\_\_\_    Longitude: \_\_\_\_\_

Found: A 3 - 5/8 inch diameter NGS disk stamped "A 743 1987" set vertically and flush in face of rock cutbank. Approx. 3 - 1/2 feet above ground.

To reach: From the intersection of Twelve Mile Creek Road (BLM road 30-09-10.0) and State Hwy. 42 in T30S R9W Sec11 proceed westerly along Hwy. 42 approx. 0.5 miles to milepoint 48.8 and monument on right

