

OFFICE OF THE
DOUGLAS COUNTY SURVEYOR

B-014



D-01
B-014

365 54

414816.53 414816.53
424613.4 424613.4

Station: B 609 T 32 S, R 5W , Sec 21

Set By (Agency): OSHD

Date Set: 1967

Recovered By RWS, SJF


Date Recovered January 24, 1985

Recovered By _____

Date Recovered _____

Recovered By _____

Date Recovered _____

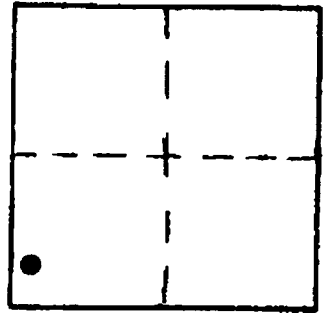

VERTICAL CONTROL

CORPCON 6 NAVD88 1516.29 FT

Elevation: 1512.86 NGS Line # _____ USGS Line # _____ OSHD Line # 369

Precision: 3rd Agency: OSHD Proj. # _____ Date: 1980

HORIZONTAL CONTROL

South Zone State Plane Coordinates: Y(Northing) 414,854.74 X(Easting) 1,246,764.74

Precision: 1/25,000 Agency: DCSO Proj. # 2013 Date: 1985

Approximate Geographic Position: Latitude 42° 46' 13" Longitude 123° 18' 21"

DESCRIPTION and TO REACH


DESCRIPTION:

A standard OSHD disk stamped "B 609 1967"
set flush in southwest corner of concrete
inlet box for storm drain.

TO REACH:

From the Barton Rd. overcrossing of Inter-
state Highway 5 in T32S,R5W,Sec.30, proceed
northeasterly along I-5 approximately 1.3
miles to monument on left.

SKETCH

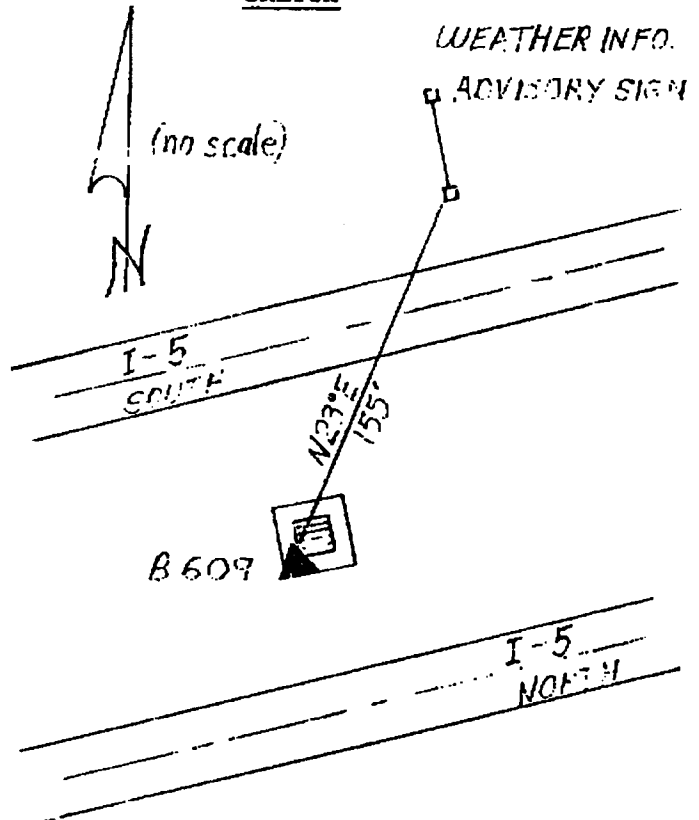

Reference Marks:

Note: For further information, contact the Douglas County Surveyor's Office, Room 205
Douglas County Justice Building, Roseburg, OR 97470. Phone 440-4278. Douglas
County residents outside the Roseburg calling area, dial toll free 1-800-452-0991.