


OFFICE OF THE  
DOUGLAS COUNTY SURVEYOR

B-017 258 34 6  
BAD  
NAD 83 451973.20 4171938.23  
43°25'16" 123°19'16"

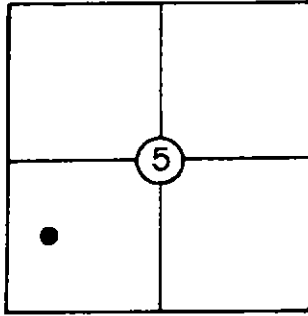

T 25 S, R 5 W, Sec. 5  
Station: BAD (DCSO)  
Set By (Agency): OSHD  
Date: 1980 (DCSO)

VERTICAL CONTROL

Elevation: 511.865 NGS(USC&GS) Line # \_\_\_\_\_ USGS Line # \_\_\_\_\_  
(Calapooya)  
Order Of Precision 2nd-I Agency: DCSO Proj. #: 2006 Date: 1981

HORIZONTAL CONTROL

Oregon State Plane Coordinates: Y(Northing) 652,008.13 X(Easting) 1,250,976.96  
(South Zone)  
(Calapooya)  
Order Of Precision 1/25,000 Agency: DCSO Proj. #: 2006 Date: 1981


Approximate Geographic Position: Latitude= 43° 25' 16" Longitude= 123° 19' 12"

DESCRIPTION: A OSHD brass cap set in conc.  
curbing 0.8 ft. above pavement, 17 ft. SW'ly  
of centerline of Co. Rd. #23. 0.6 ft. NW'ly  
from conc. bridge decking.

TO REACH: From Hwy 99 in Oakland proceed N'ly  
to Co. Rd. #23. Going W'ly to overpass crossing  
I-5 Hwy approx. 0.9 mi.

VICINITY: Cap located at Southeasterly end of  
Co. Rd. #23 overpass crossing I-5 West of Oakland

SKETCH

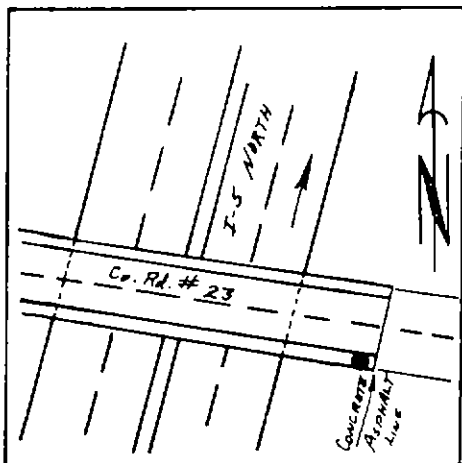

NOTE: For Possible Further Information On This Station, Please Contact The Douglas County Surveyors Office, Rm. 205 Douglas County Justice Bldg., Roseburg, OR. 97470 Phone 672-3311 Ext. 272. Douglas County residents outside the Roseburg calling area dial toll free 1-800-452-0991.