

OFFICE OF THE
DOUGLAS COUNTY SURVEYOR

Station: BENTZ T 28 S, R 6W , Sec 29

Set By (Agency): Don Garrett LS#0544

Date Set: 1972

Recovered By R.S., S.J.F.



Date Recovered March 14, 1984

Recovered By _____

Date Recovered _____

Recovered By _____

Date Recovered _____

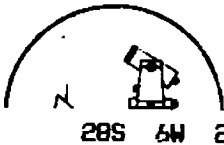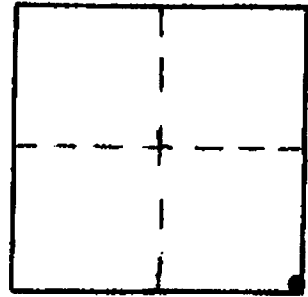

b-045
BENTZ

28S 6W 29

NAD 535400.03 4140382.15
83 43° 5'54" 123°25'28"

VERTICAL CONTROL NGVD 29 CORPCOM 6 NAVD 88 707.38 FT

Elevation: 703.93 NGS Line # _____ USGS Line # _____ OSHD Line # _____

Precision: 3rd Agency: Don Bentz Proj. # _____ Date: 1972

HORIZONTAL CONTROL OCS 27 LS#0839

South Zone State Plane Coordinates: Y(Northing) 535,435.17 X(Easting) 1,219,423.90

Precision: 1/25,000 Agency: DCSO Proj. # 2005 C.S. 56/9 Date: 1972

Approximate Geographic Position: Latitude 43°08'55" Longitude 123°25'24"


DESCRIPTION and TO REACH

SKETCH

A DCSO disk stamped "BENTZ 1972"; Set on an iron pipe protruding 10 inches above the ground.

To Reach:

From the intersection of State Highway 99 and Hult Avenue (Co. Rd. #158A) in T28S, R6W, Sec. 29, proceed northerly along Highway 99 approximately 250 ft. to the intersection with a private roadway on the right. Follow private roadway, crossing S.P. rail line, approximately 100 ft. easterly to intersection with Roseburg Lumber property access road on right. Follow Roseburg Lumber road southerly approximately 0.35 miles to intersection left. The monument is approximately 500 ft. easterly from the intersection, up a steep hill.

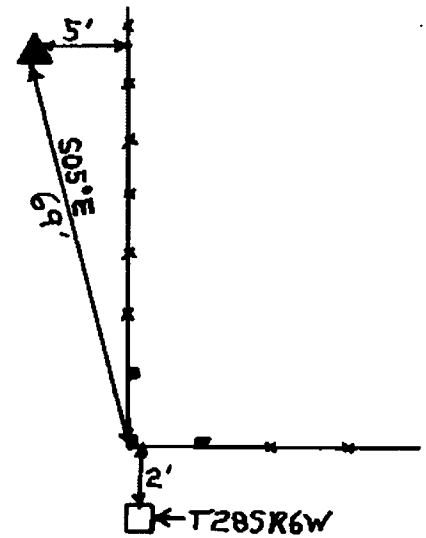

Reference Marks:

S29	S28
S32	S33

Note: For further information, contact the Douglas County Surveyor's Office, Room 205 Douglas County Justice Building, Roseburg, OR 97470. Phone 440-4278. Douglas County residents outside the Roseburg calling area, dial toll free 1-800-452-0991.