

OFFICE OF THE
DOUGLAS COUNTY SURVEYOR

Station: BM-4 T 24 S, R 5 W, Sec 16

Set By (Agency): DCPW

Date Set: 1977

Recovered By RWS,SJF


Date Recovered 9/3/87

Recovered By _____

Date Recovered _____

Recovered By _____

Date Recovered _____

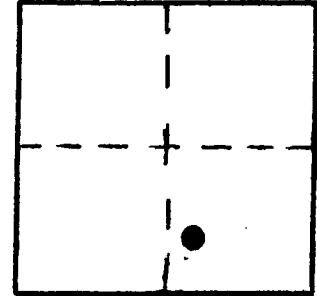

b-061
BM-4

24S 5W 16

NAD 672600.04 4179721.11
83 43°28'42" 123°17'40"

VERTICAL CONTROL NGVD 29 CORPCON 6 NAVD 88 588.93 FT

Elevation: 585.40 NGS Line # _____ USGS Line # _____ OSHD Line # _____

Precision: 3rd Agency: DCPW Proj. # Pollack Cr. Date: 1977

HORIZONTAL CONTROL OCS 27

South Zone State Plane Coordinates: Y(Northing) 672,634.47 X(Easting) 1,258,761.43

Precision: 1/25,000 Agency: DCSO Proj. # 2010-4, CS 59/47 Date: 1978

Approximate Geographic Position: Latitude 43°28'42" Longitude 123°17'36"

DESCRIPTION and TO REACH

SKETCH


A DCPW disk stamped "BM-4 1977" set in a 6 in. dia. concrete filled plastic pipe protruding 10 in. above ground.

Abridged version

TO REACH: **keyed into SARS.**

From the intersection of Goodrich Highway (Co. Rd. #29) and Hogan Rd. (Co. Rd. #190) in T24S,R5W,Sec.16, proceed southerly along Goodrich Highway 0.6 miles to monument on left.

From the intersection of South Cabin Creek Rd. (Co. Rd. #285) and Goodrich Highway (Co. Rd. #29) in T24S,R5W,Sec.20, proceed easterly and northerly along Goodrich Highway 1.6 miles to monument on right.

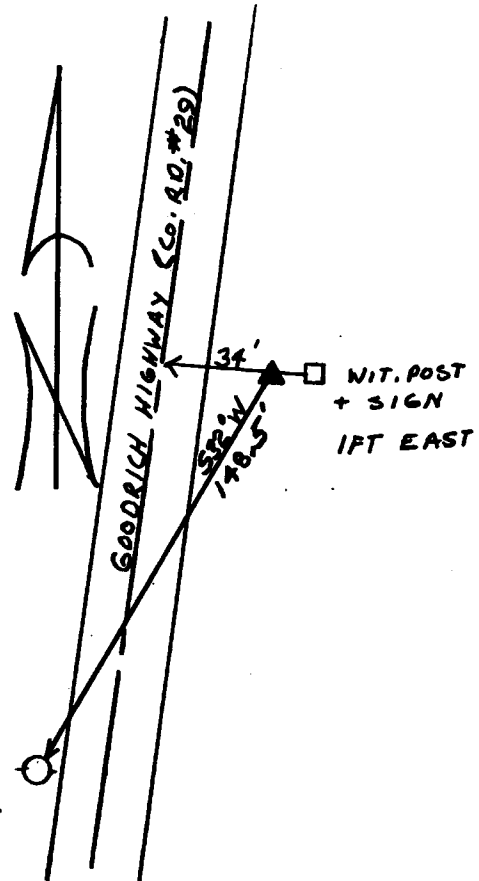

Reference Marks:

Note: For further information, contact the Douglas County Surveyor's Office, Room 205 Douglas County Justice Building, Roseburg, OR 97470. Phone 440-4278. Douglas County residents outside the Roseburg calling area, dial toll free 1-800-452-0991.