

OFFICE OF THE
DOUGLAS COUNTY SURVEYOR

Station: BM-5 T 24 S, R 5 W , Sec 16

Set By (Agency): DCPW

Date Set: 1977

Recovered By RWS,SJF


Date Recovered 9/3/87

Recovered By FD OK DCSO 1/2000

Date Recovered _____

Recovered By _____

Date Recovered _____

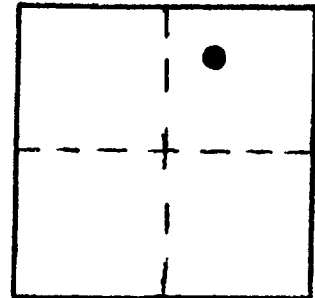

b-063
BM-5

24S 5W 16

NAD 675927.31 4180141.00
83 43°29'15" 123°17'36"

VERTICAL CONTROL NGVD 29 CORPCON 6 NAVD 88 700.21 FT
Elevation: 696.67 NGS Line # _____ USGS Line # _____ OSHD Line # _____
Precision: 3rd Agency: DCPW Proj. # POLLACK CRK. Date: 1977

HORIZONTAL CONTROL OCS 27
South Zone State Plane Coordinates: Y(Northing) 675,961.74 X(Easting) 1,259,181.28
Precision: 1/25,000 Agency: DCSO Proj. # 2010-4,CS 59/47 Date: 1978
Approximate Geographic Position: Latitude 43°29'15" Longitude 123°17'31"


DESCRIPTION and TO REACH

SKETCH

A DCPW 2 1/2 in. dia. disk stamped "BM-5 1977"
set in a 6 in. dia. concrete filled plastic
pipe protruding 3 in. above ground.

TO REACH:

Monument is in southeast corner of intersection
of Goodrich Highway (Co.Rd.#29) and Hogan Road
(Co.Rd.#190) in T24S,R5W,Sec.16.

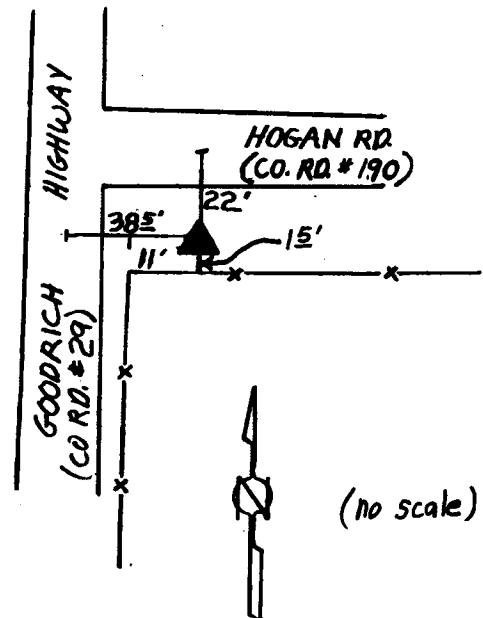

Reference Marks:

Note: For further information, contact the Douglas County Surveyor's Office, Room 205
Douglas County Justice Building, Roseburg, OR 97470. Phone 440-4278. Douglas
County residents outside the Roseburg calling area, dial toll free 1-800-452-0991.