
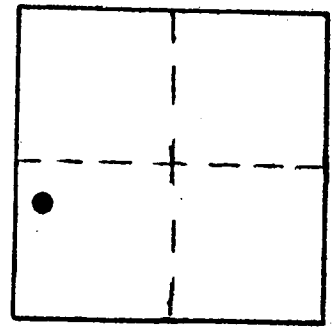


OFFICE OF THE
DOUGLAS COUNTY SURVEYOR

Station: BUELL T 28 S, R 7W, Sec 1
Set By (Agency): DCSO
Date Set: 1985
Recovered By RWS, SJF, JRL
Date Recovered 3-4-85
Recovered By _____
Date Recovered _____
Recovered By _____
Date Recovered _____

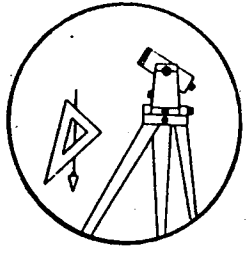

B-100

VERTICAL CONTROL

Elevation: 568.037 ft. NGS Line # _____ USGS Line # _____ OSHD Line # _____
Precision: 2nd Agency: DCSO Proj. # 2013 Date: 1985

HORIZONTAL CONTROL CORPSCON6 NAVD88 571.48 FT. CS66/61

South Zone State Plane Coordinates: Y(Northing) 558861 X(Easting) 4125896
Precision: GIS SCALED Agency: DCSO Proj. # _____ Date: 2014
Approximate Geographic Position: Latitude 43° 09' 41" Longitude 123° 28' 50"

DESCRIPTION and TO REACH


SKETCH

DESCRIPTION:

A DCSO disk stamped "BUELL 1985"
set flush in raised concrete curb
at north east corner of bridge.

TO REACH:

From the intersection of Brock-
way-Lookingglass Rd.(Co. Rd. #47)
and Dairy Loop Rd. (Co. Rd. #108)
in T28S, R7W, Sec. 2, proceed
southeasterly along Co. Rd. #47
0.5 miles to bridge over small
creek and moundment on left.

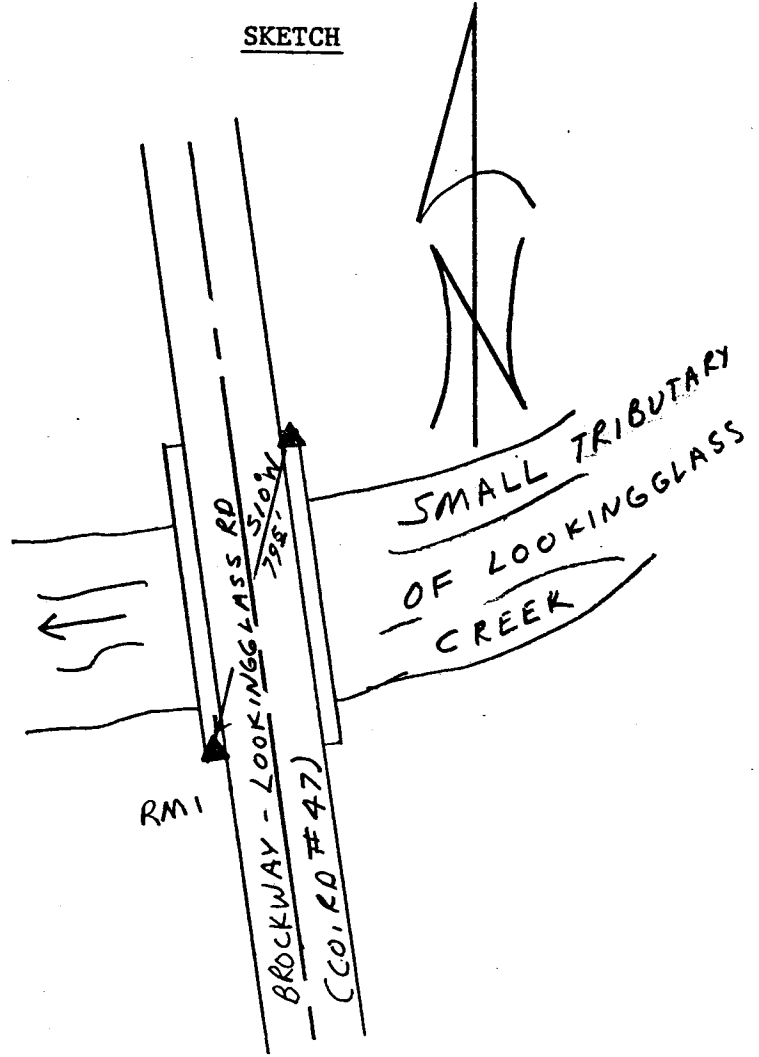

Reference Marks:

A DCSO disk stamped "BUELL RM1 1985"
bears S10°W, 795' (geod.) elev. 568.004 ft.

Note: For further information, contact the Douglas County Surveyor's Office, Room 205
Douglas County Justice Building, Roseburg, OR 97470. Phone 440-4278. Douglas
County residents outside the Roseburg calling area, dial toll free 1-800-452-0991.